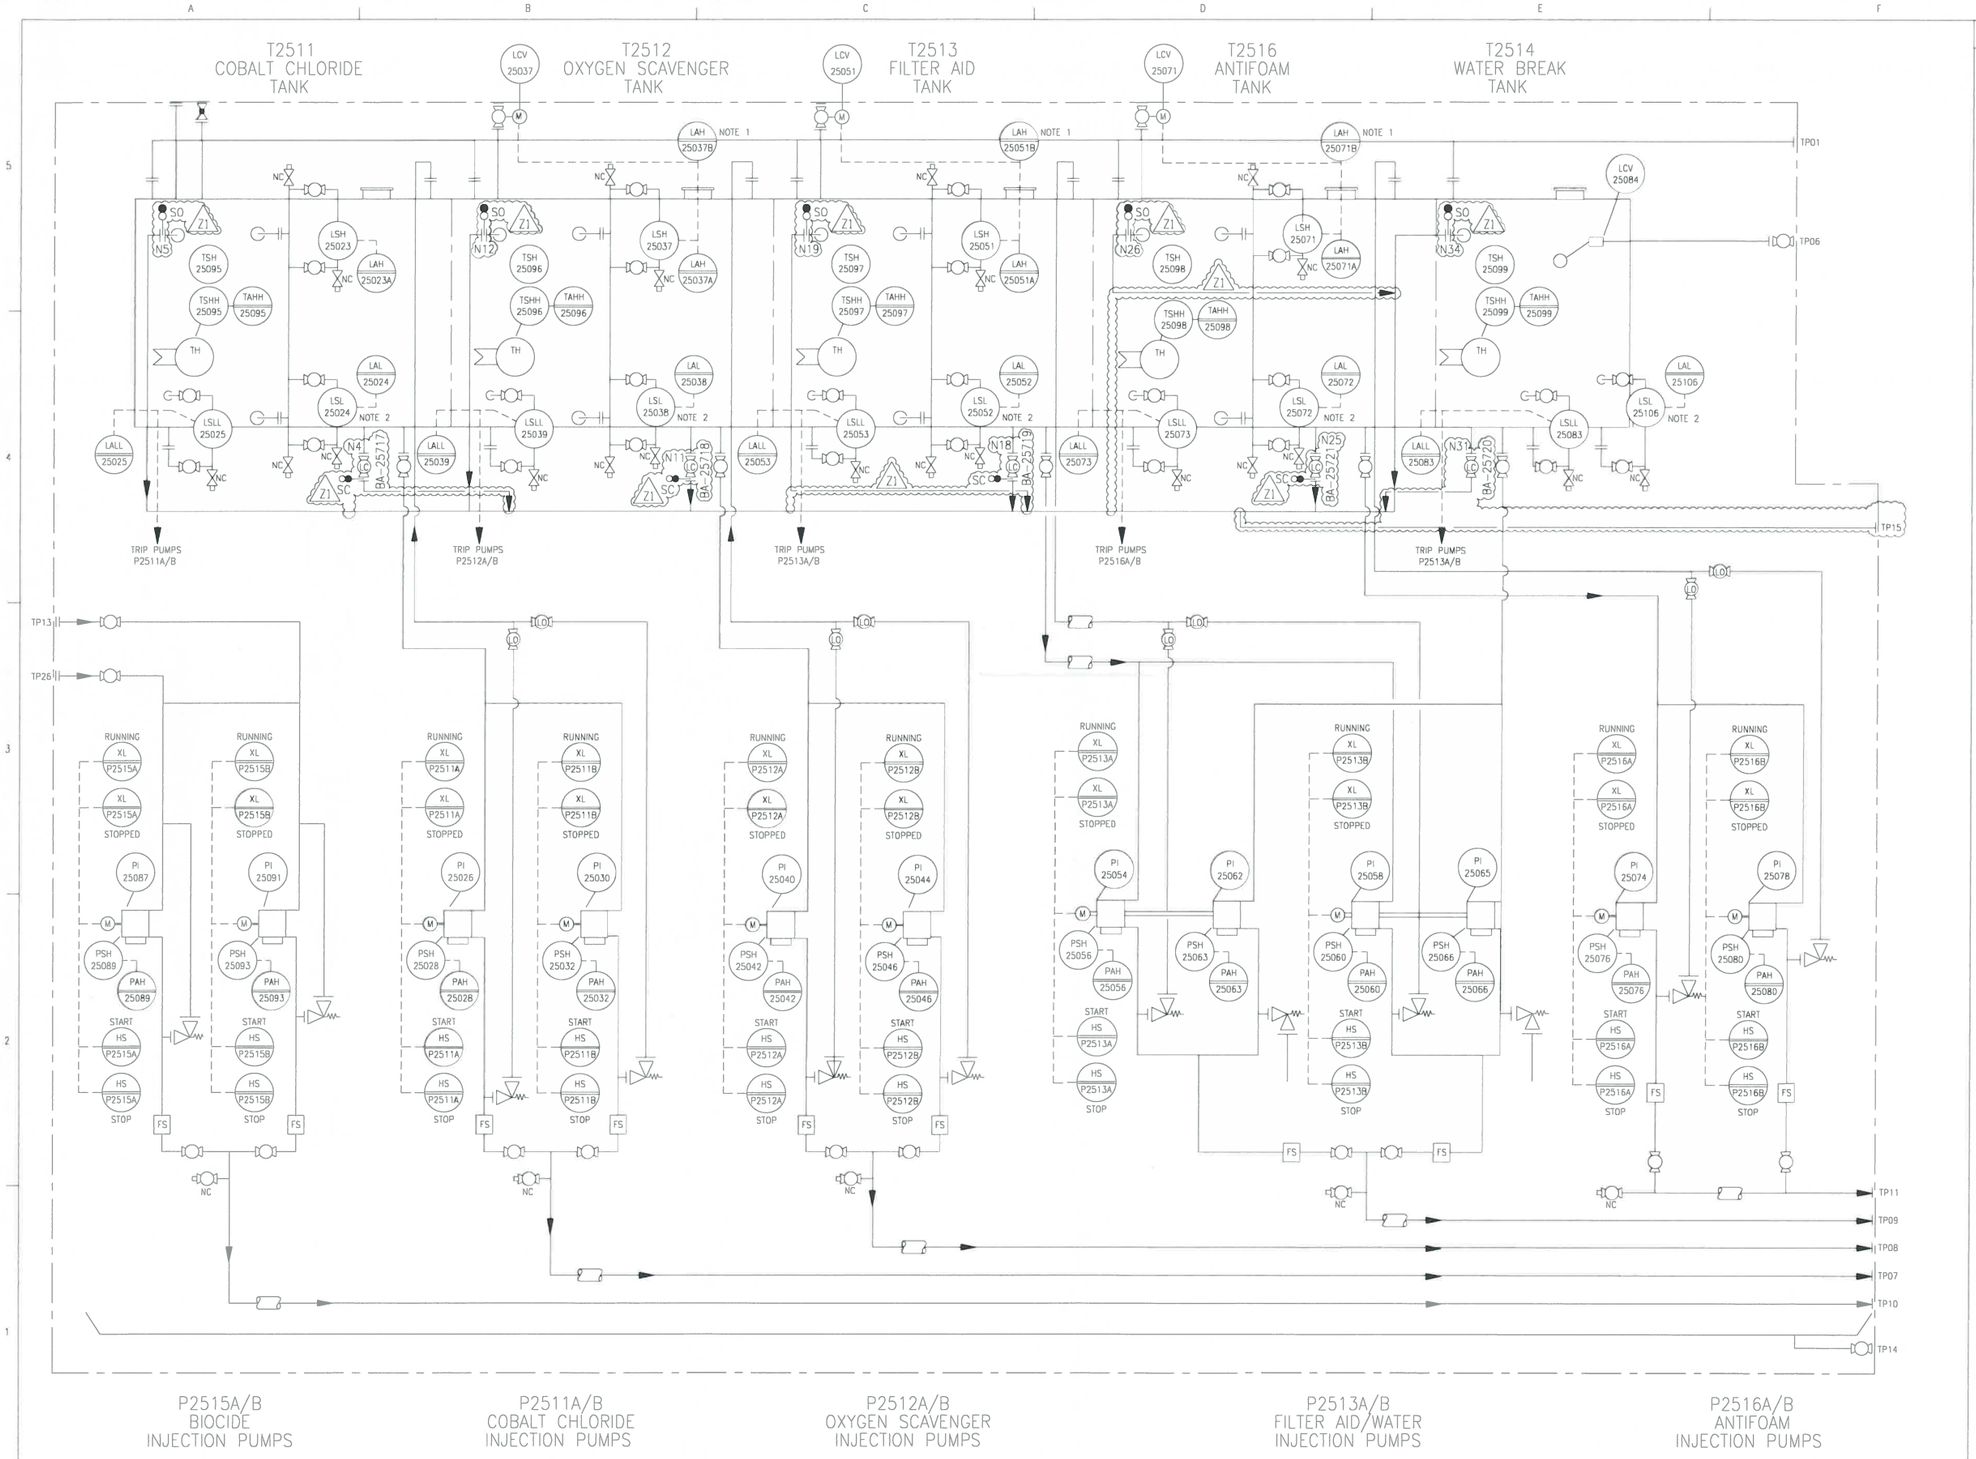

NOTES

1. HIGH LEVEL ALARMS ARE REPEATED TO TOTE TANK FILLING AREA PANEL.
2. HEATER IS INHIBITED ON TANK LOW LEVEL.
3. HEATER FITTED WITH INDEPENDENT OVER TEMPERATURE TRIP WITH MANUAL RESET.
4. FOR CONTINUATION DETAILS REFER TO DRAWING No: SCOTT-FW-0000-PR-PD-0107-01.

THIS DRAWING WAS PRODUCED FROM BRAN & LUEBBE VENDOR P & ID No. S2624 Sheet. 4 REV 2 AND SUPERSEDES P0114-D-0004-03

REFERENCE DRAWINGS

DRG.No.	REV	TITLE
SCOTT-AK-0000-PR-PD-0107-01 TO 04	10	P&ID FOR WATER INJ./CHEMICAL INJ. PACKAGE UNIT (Shts.01-04)

REV	REASON FOR ISSUE	DATE	DRN.	CKD.	BY ENG	ENG CKD.	L.E. APP'D	NEXEN APP'D
Z1	AS BUILT FOR SEQ1596	31.05.18	DD	LM	LM	JL	JL	
10	AS BUILT FOR SEQ1227	15.04.09	JJ	EC	EC	AL	AL	GL

REV	REASON FOR ISSUE	DATE	DRN.	CKD.	BY ENG	ENG CKD.	L.E. APP'D	NEXEN APP'D

nexen
Nexen Petroleum U.K. Limited
Nexen House,
Horeness Road,Altens,
Aberdeen AB12 3LE
Tel: (01224) 371100
Fax: (01224) 371101

THIS IS A C.A.D. PRODUCED DRAWING AND SHOULD NOT BE MANUALLY MODIFIED

SCOTT

WorleyParsons
resources & energy

TITLE
PIPING & INSTRUMENT DIAGRAM
WATER INJECTION/CHEMICAL INJECTION
PACKAGE UNIT

DRAWING No. SCOTT-AK-0000-PR-PD-0107-05 | Z1 | NONE

PROJECT	ORIG	AREA/MOD	DISC	TYPE	SEQ. No.	SHT.	REV	SCALE