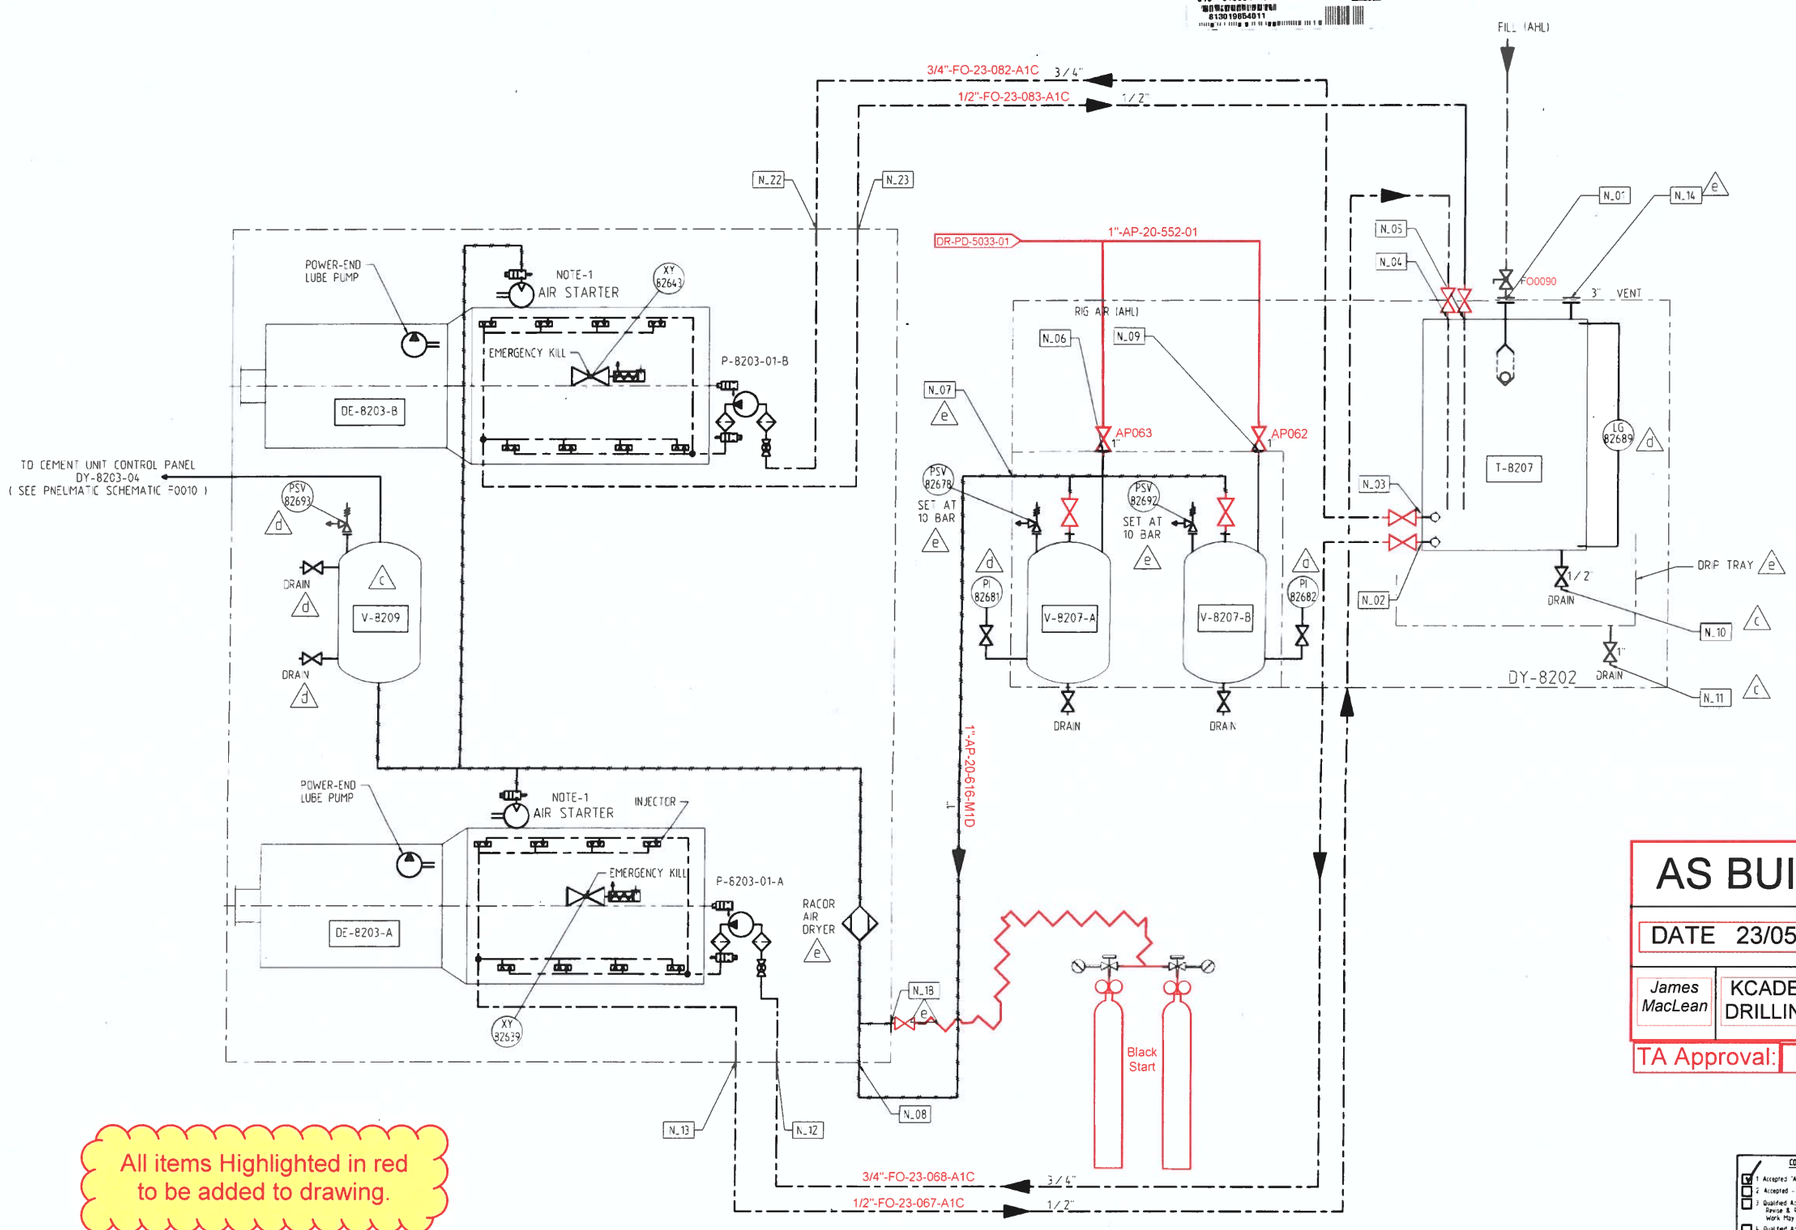

All items Highlighted in red to be added to drawing.

NOTE 1: ENGINE AIR START REQUIREMENT IS 150 cfm @ 120 psi (70° F)

FUEL LINE

AIR LINE

LUBE OIL LINES

813-019854-01-1T Hays

AS BUILT

DATE 23/05/2023

James MacLean | KCADEUTAG DRILLING LTD

TA Approval: M

AS SUPPLIED

Sellers statement : This document accurately represents the as supplied condition of the work.

Seller's Authorised Signature | Date 19-Nov-91

COMPANY RETURN CODES

- [x] 1 Accepted "As Supplied"
- [ ] 2 Accepted - No Comments
- [ ] 3 Qualified Acceptance - Minor Comments Revise & Resubmit as "As Supplied" Work May Proceed
- [ ] 4 Qualified Acceptance - Minor Comments Revise & Resubmit To Obtain Code 2 Work May Proceed
- [ ] 5 Qualified Acceptance - Major Comments Revise & Resubmit To Obtain Code 2 Work May Proceed
- [ ] 6 Rejected - Revise & Resubmit Immediately Work May Not Proceed In The Affected Areas
- [ ] 7 Review Not Required

Company's Signature | Date 22/5/92

AMERADA HESS LIMITED
SCOTT FIELD DEVELOPEMENT

Package Desc	CEMENT UNIT
Ecup Nos	DY-8203 / P-8203-01A / B DE-8203A / B
SDRS Codes	D01
Module	Sheet 1 of 1

Purchase Order No	Document No	Rev
P0131	D 0,0,0,3 0 6	

CONFIDENTIEL NE PAS REPRODUIRE N COMMUNIQUER A UN TIERS TOUT USAGE AUTRE QUE RELATIF A LA COMMANDE DE DS EST INTERDIT
CONFIDENTIAL DO NOT DUPLICATE. DO NOT DISCLOSE TO A THIRD PARTY - EACH USE NOT RELATED TO A DS ORDER IS PROHIBITED

NR	DATE	EXPLANATIONS	Name	APPRVD
F	8.91	AS SUPPLIED	B.D	
E	8.91	ADD NOZZLE N°S - LINE SIZES	B.D	JRBA
D	8.91	UPDATED AS PER INDICATIONS	L.V	JRBA
C	8.91	ADD TAG NO'S	L.V	JPBOUDET
B	12.91	UPDATED AS PER INDICATIONS	L.V	JPBOUDET

USED ON: AMERADA HESS SCOTT FIELD

Etudes et Fabrication DS — DOWELL SCHLUMBERGER
ZI Molina le Chazette BP90 42003 ST-ETIENNE CEDEX
FRANCE 77-32-54-23 Telex 300095 (ORANGE)

P&ID . SHEET 3 OF 4
ENGINE AIR AND FUEL

DRAWN	CHKD	APPRVD	SCALE NONE	FOLIO 3/4	REV
A.CHAUDIER 03/01/91	JP.BOUDET 03/01/91	M.HOOVER 01/91	1E+918460AHS		F

SIC0116-SCOTT-P0131-D-0003-00-TP01 M1