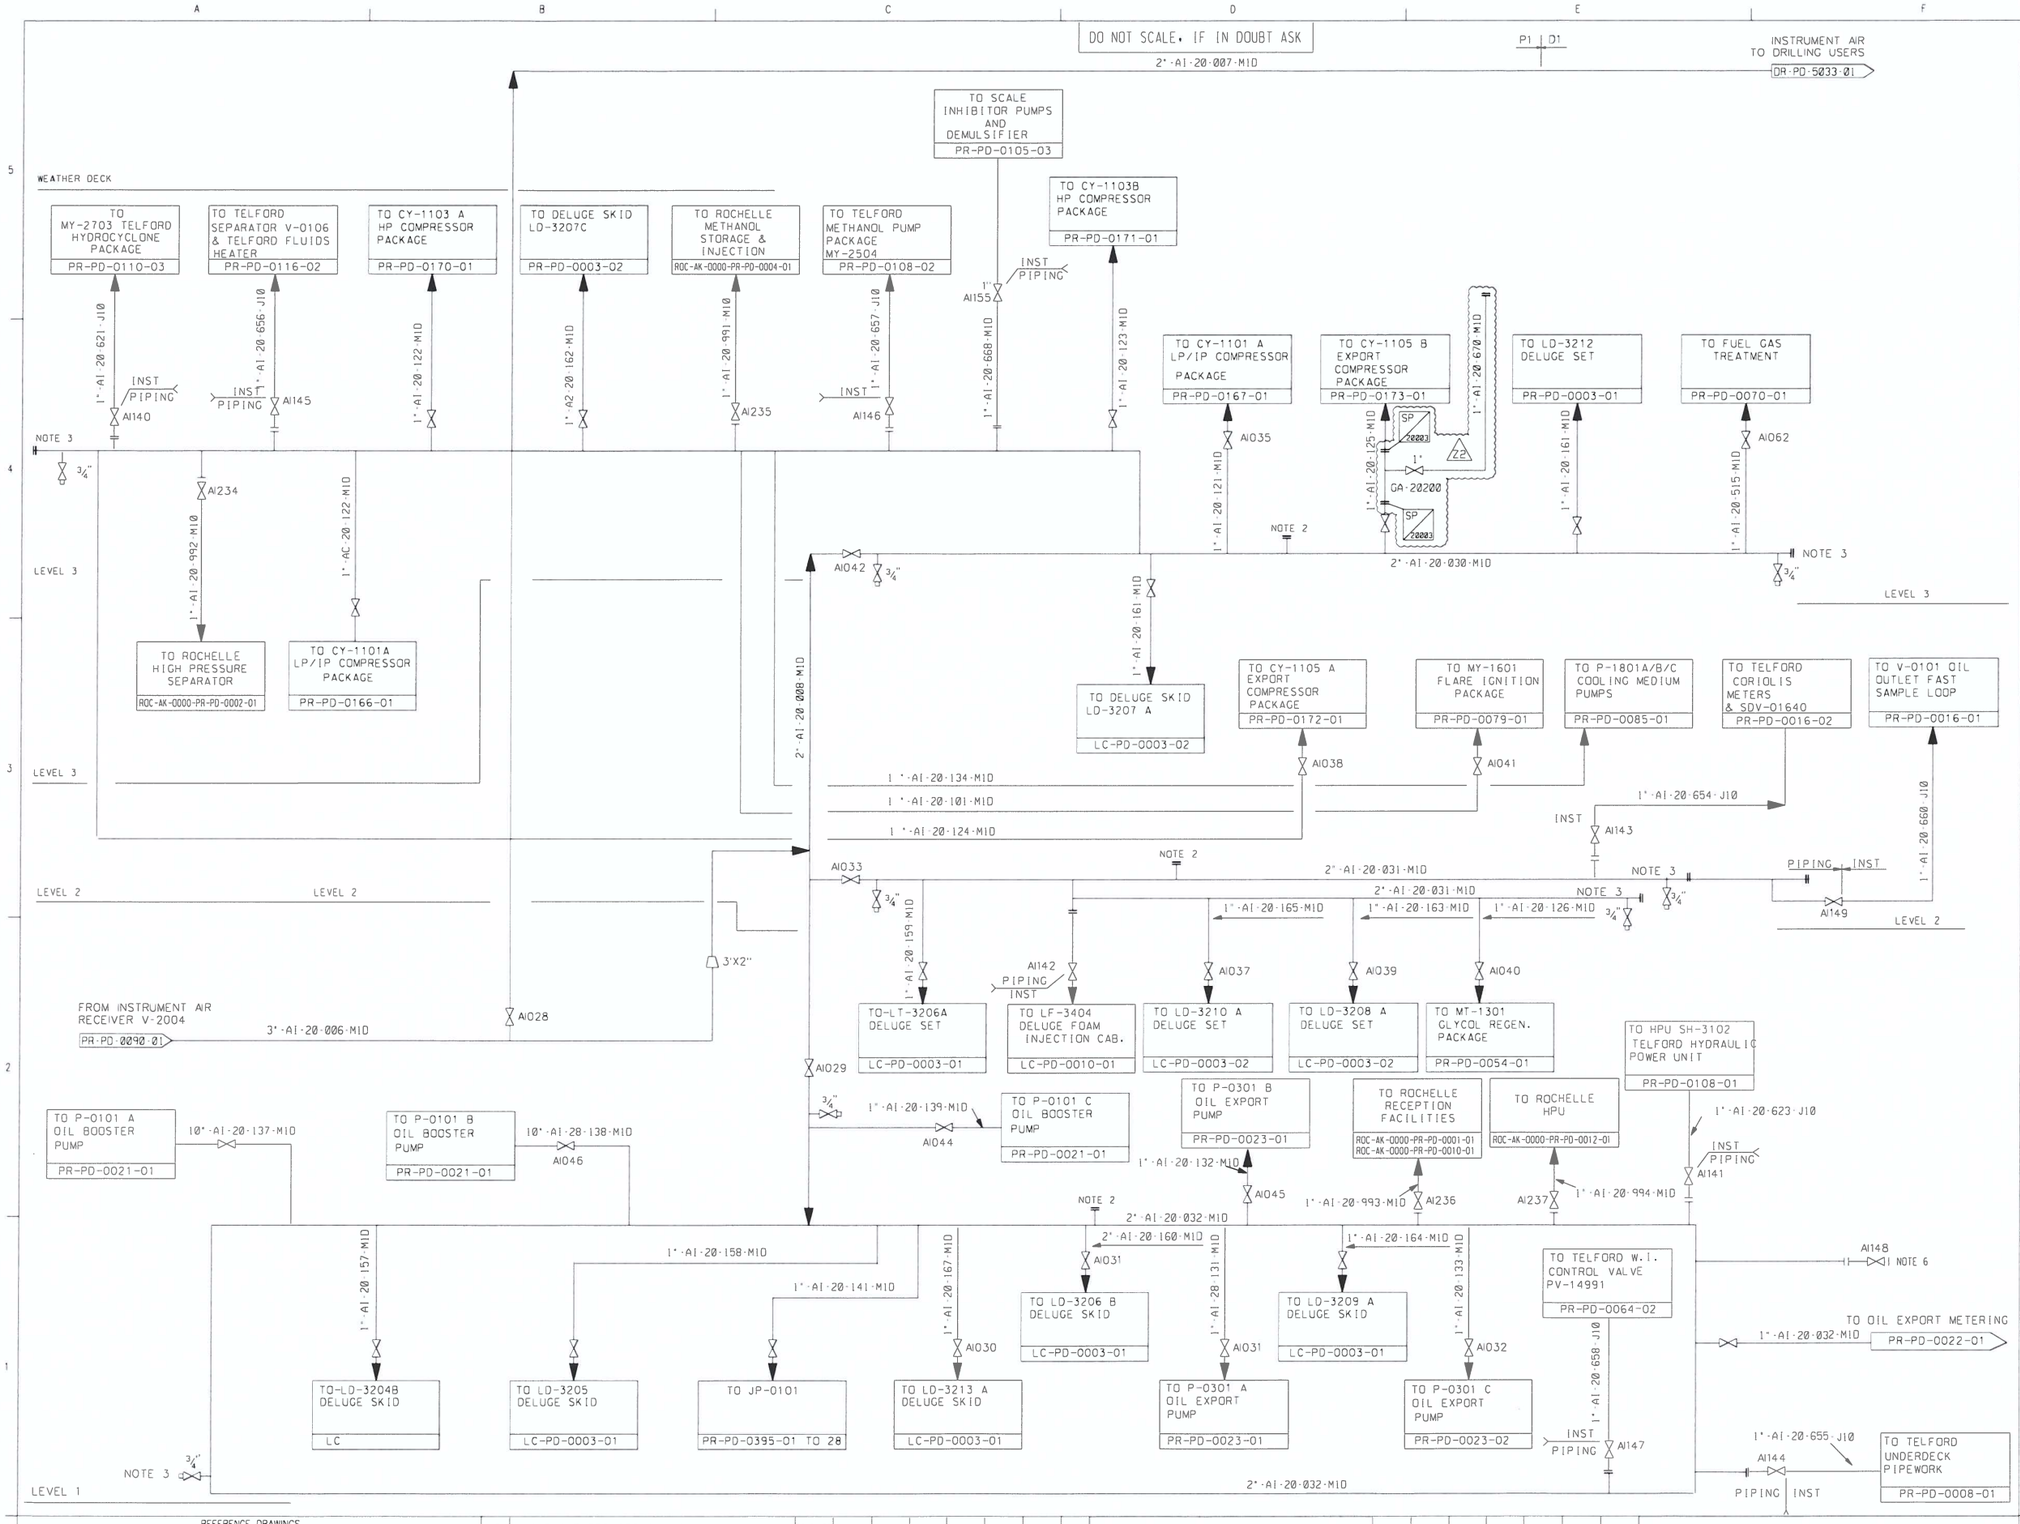

NOTES

1. DELETED.
2. BLIND STUBS TO BE PROVIDED AT 3m CENTRES.
3. HEADER ENDS REQUIRE VENT VALVE TO FACILITATE BLOW THROUGH AT COMMISSIONING AND START-UP. VALVE TEED FROM UNDERSIDE OF HEADER AT MINIMUM DISTANCE FROM HEADER END.
4. LEVEL 4 INSTRUMENT AIR REQUIREMENTS TO BE TAKEN FROM LEVEL 3 HEADER.
5. DELETED.
6. SPARE CONNECTION.

ONLY ACTIVATED TRACE HEATING IS SHOWN ON P & ID. ALL OTHER INSTALLED TRACE HEATING IS NOT ACTIVATED AND NOT SHOWN ON P & ID.

FOR APPROVAL SIGNATURES SEE ARCHIVED DRAWING AT REV 0

REFERENCE DRAWINGS

DRG.No.	REV	TITLE
		DCP5000 AH671 ARN 3200 (EP 235)
		DCP5000 AH1054

REV	REASON FOR ISSUE	DATE	DRN.	CKD.	BY ENG	ENG CKD.	L.E. APP'D	CNOOC APP'D
17	AS BUILT PER SEQ1222 ONLY	22.01.08	VM	MU	MU	AL	AL	GL
16	REVISED TO LATEST INFORMATION	21.02.07	FR	CS	CS	AL	AL	SC
15	AS BUILT FOR SEQ1222	19.10.06	FR	CS	CS	AL	AL	SC
14	AS BUILT PER OFFSHORE SURVEY	31.7.97	AD					
13	AS BUILT FOR TELFORD	27.1.97	DH	GWM				
12	AS BUILT TO INCLUDE DO-254	14.07.95	WN	GWM			KJH	

REV	REASON FOR ISSUE	DATE	DRN.	CKD.	BY ENG	ENG CKD.	L.E. APP'D	CNOOC APP'D
Z2	AS-BUILT FOR SMOC1952	24/6/16	PCL	JL	JL	MM	JL	AL
Z1	AS-BUILT FOR SMOC1979	21.02.18	DD	AWC	AWC	LM	AWC	
18	AS BUILT AS PER SEQ1470 (CS-WP-20)	01.10.13	KD	CMA	CMA	CMA	NW	TR

cnooc

NEXEN HOUSE,
HARENESS ROAD, ALTENS,
ABERDEEN, AB12 3LE
TEL: (01224) 371100
FAX: (01224) 371101

THIS IS A C.A.D. PRODUCED DRAWING AND SHOULD NOT BE MANUALLY MODIFIED

Worley
energy | chemicals | resources

TITLE
PIPING AND INSTRUMENT DIAGRAM INSTRUMENT AIR DISTRIBUTION DP

DRAWING No.
SCOTT-FW-0000-PR-PD-0092-01 | Z2 | NONE

PROJECT	ORIG	AREA/MOD	DISC	TYPE	SEQ. No.	SHT		REV	SCALE