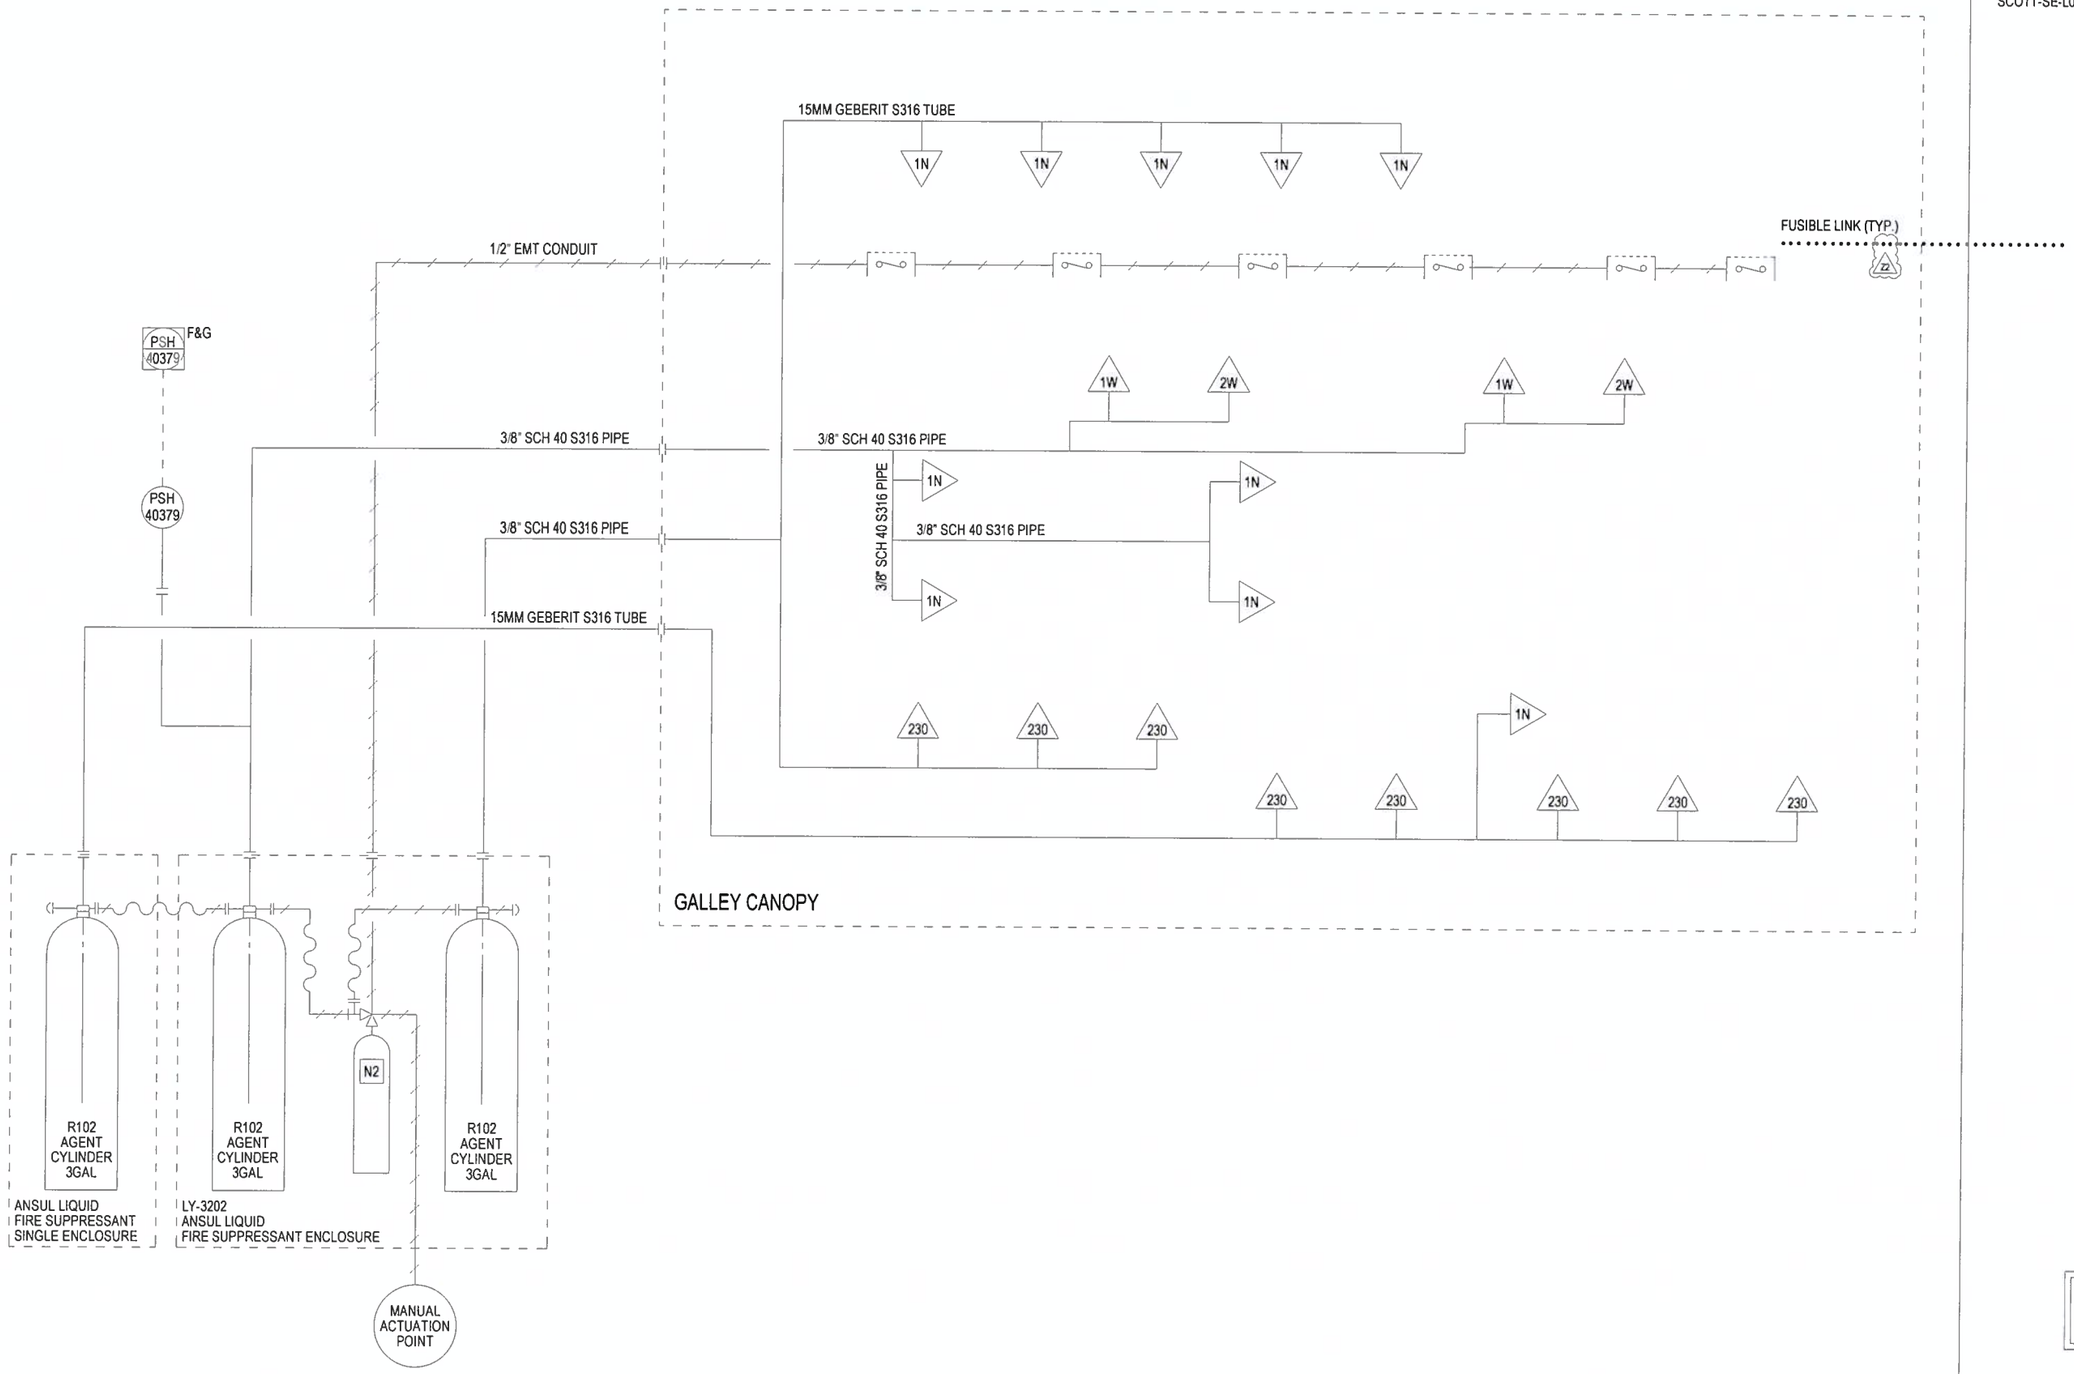

NOTES

1. FUSIBLE LINKS AND NOZZLES TO BE INSTALLED IN GALLEY HOOD AND EXTRACT DUCTWORK IN ACCORDANCE WITH SPEC: SCOTT-SE-L000-LC-SP-0003-00.

FOR ORIGINAL DESIGN APPROVAL SIGNATURES SEE ARCHIVED DRAWING AT REV 0

REFERENCE DRAWINGS

DRG No	REV	TITLE

REV	REASON FOR ISSUE	DATE	DRN	CKD	BY ENG	ENG CKD	L.E. APP'D	CNOOC APP'D
Z2	AS-BUILT FOR SMOC2097	07/09/22	TPK	TPK	TPK	TF	TF	
Z1	AS-BUILT FOR SMOC2046	15/01/21	TF	TF	TF	JL	JL	TR
11	REDRAWN ON CAD & AS-BUILT TO INCLUDE DO-256	25/07/95	WN	-	-	JN	-	

REV	REASON FOR ISSUE	DATE	DRN.	CKD	BY ENG	ENG CKD.	L.E. APP'D	CNOOC APP'D

CNOOC

THIS IS A C.A.D. PRODUCED DRAWING AND SHOULD NOT BE MANUALLY MODIFIED

Worley
energy | chemicals | resources

TITLE
PIPING & INSTRUMENT DIAGRAM
GALLEY CANOPY
FIRE PROTECTION

DRAWING No.
SCOTT-SE-L100-LC-PD-0005-00

Z2

NTS

PROJECT	ORIG	AREA/MOD	DISC	TYPE	SEQ. No.	SHT.	REV	SCALE