INJECTION PUMPS
P-2560A (DUTY) P-2560B (STANDY) (NOTE 4)

TYPE:	DOUBLE DIAPHRAGM (PTFE)	DESIGN TEMPERATURE:	-10°C/+40°C	SI HEADS 200.2 L/DAY
MATERIAL:	316/316L SS	OPERATING TEMPERATURE:	-6°C/+23.3°C	CI HEADS 124.8 L/DAY
DESIGN PRESSURE:	320 BARG	MOTORS:	Exde. IP56, 440V, Ø3, 60Hz	
		PUMP TYPE:	LEWA LDC3	

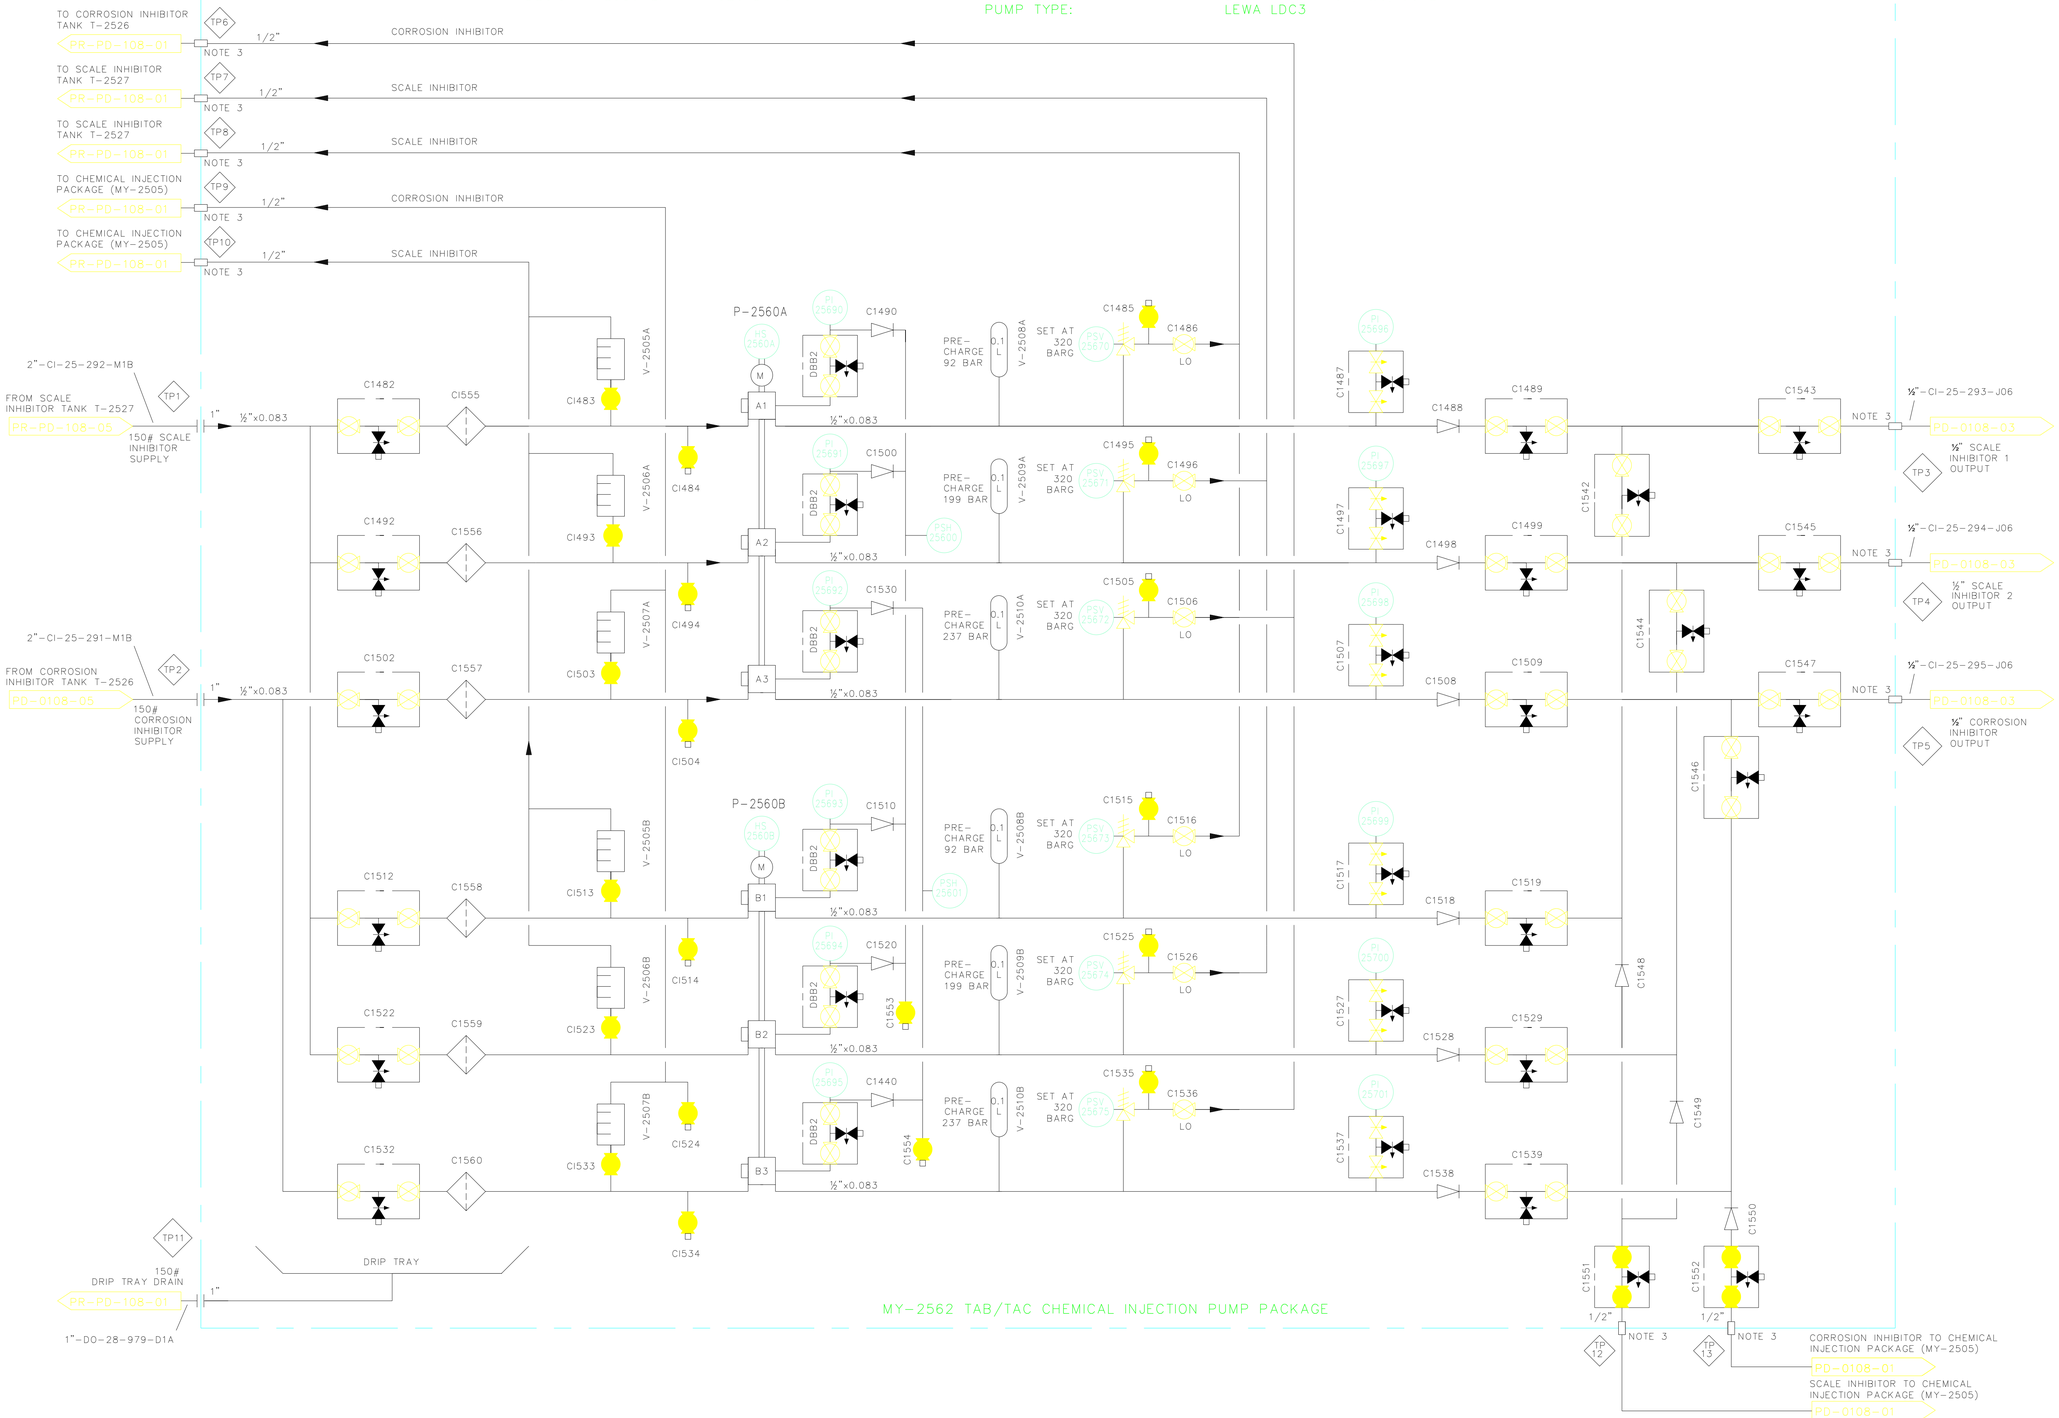

NOTES

1. ALL TUBING IS SEAMLESS 316 STAINLESS STEEL TO ASTM A269/A213 – IMPERIAL.
2. TUBE FITTINGS ARE TWIN FERRULE COMPRESSION TYPE 316 STAINLESS STEEL-IMPERIAL-PARKER A-LOK.
3. BULKHEAD UNION.
4. REFER TO SEQ-1608-ME-01-C01-0001-01 AND SEQ-1602-ME-01-C01-0001-02 FOR VENDOR P&ID'S.
5. DRAWING PREVIOUSLY ISSUED AS SCOTT-007939-T200-PR-PI-0002-01.

REFERENCE DRAWINGS

DRG.No.	REV	TITLE

REV	REASON FOR ISSUE	DATE	DRN.	CKD.	BY ENG	ENG CKD.	L.E. APP'D	NEXEN APP'D
Z1	AD-HOC AS-BUILT (RE-NUMBERED, NOTE 5)	24/02/16	TW	LM	LM	AH	AH	TR

nexen
Nexen Petroleum U.K. Limited
Nexen House,
Horeness Road,Altens,
Aberdeen.AB12 3LE
Tel: (01224) 371100
Fax: (01224) 371101

THIS IS A C.A.D. PRODUCED DRAWING AND SHOULD NOT BE MANUALLY MODIFIED

SCOTT

amec foster wheeler

TITLE
PIPING & INSTRUMENT DIAGRAM
TAB/TAC TOPSIDES CHEMICAL INJECTION PACKAGE
MY-2562

DRAWING No.
SCOTT-007939-0000-PR-PI-0108-06

Z1 NONE

PROJECT	ORIG	AREA/MOD	DISC	TYPE	SEQ. No.	SHT.	REV	SCALE