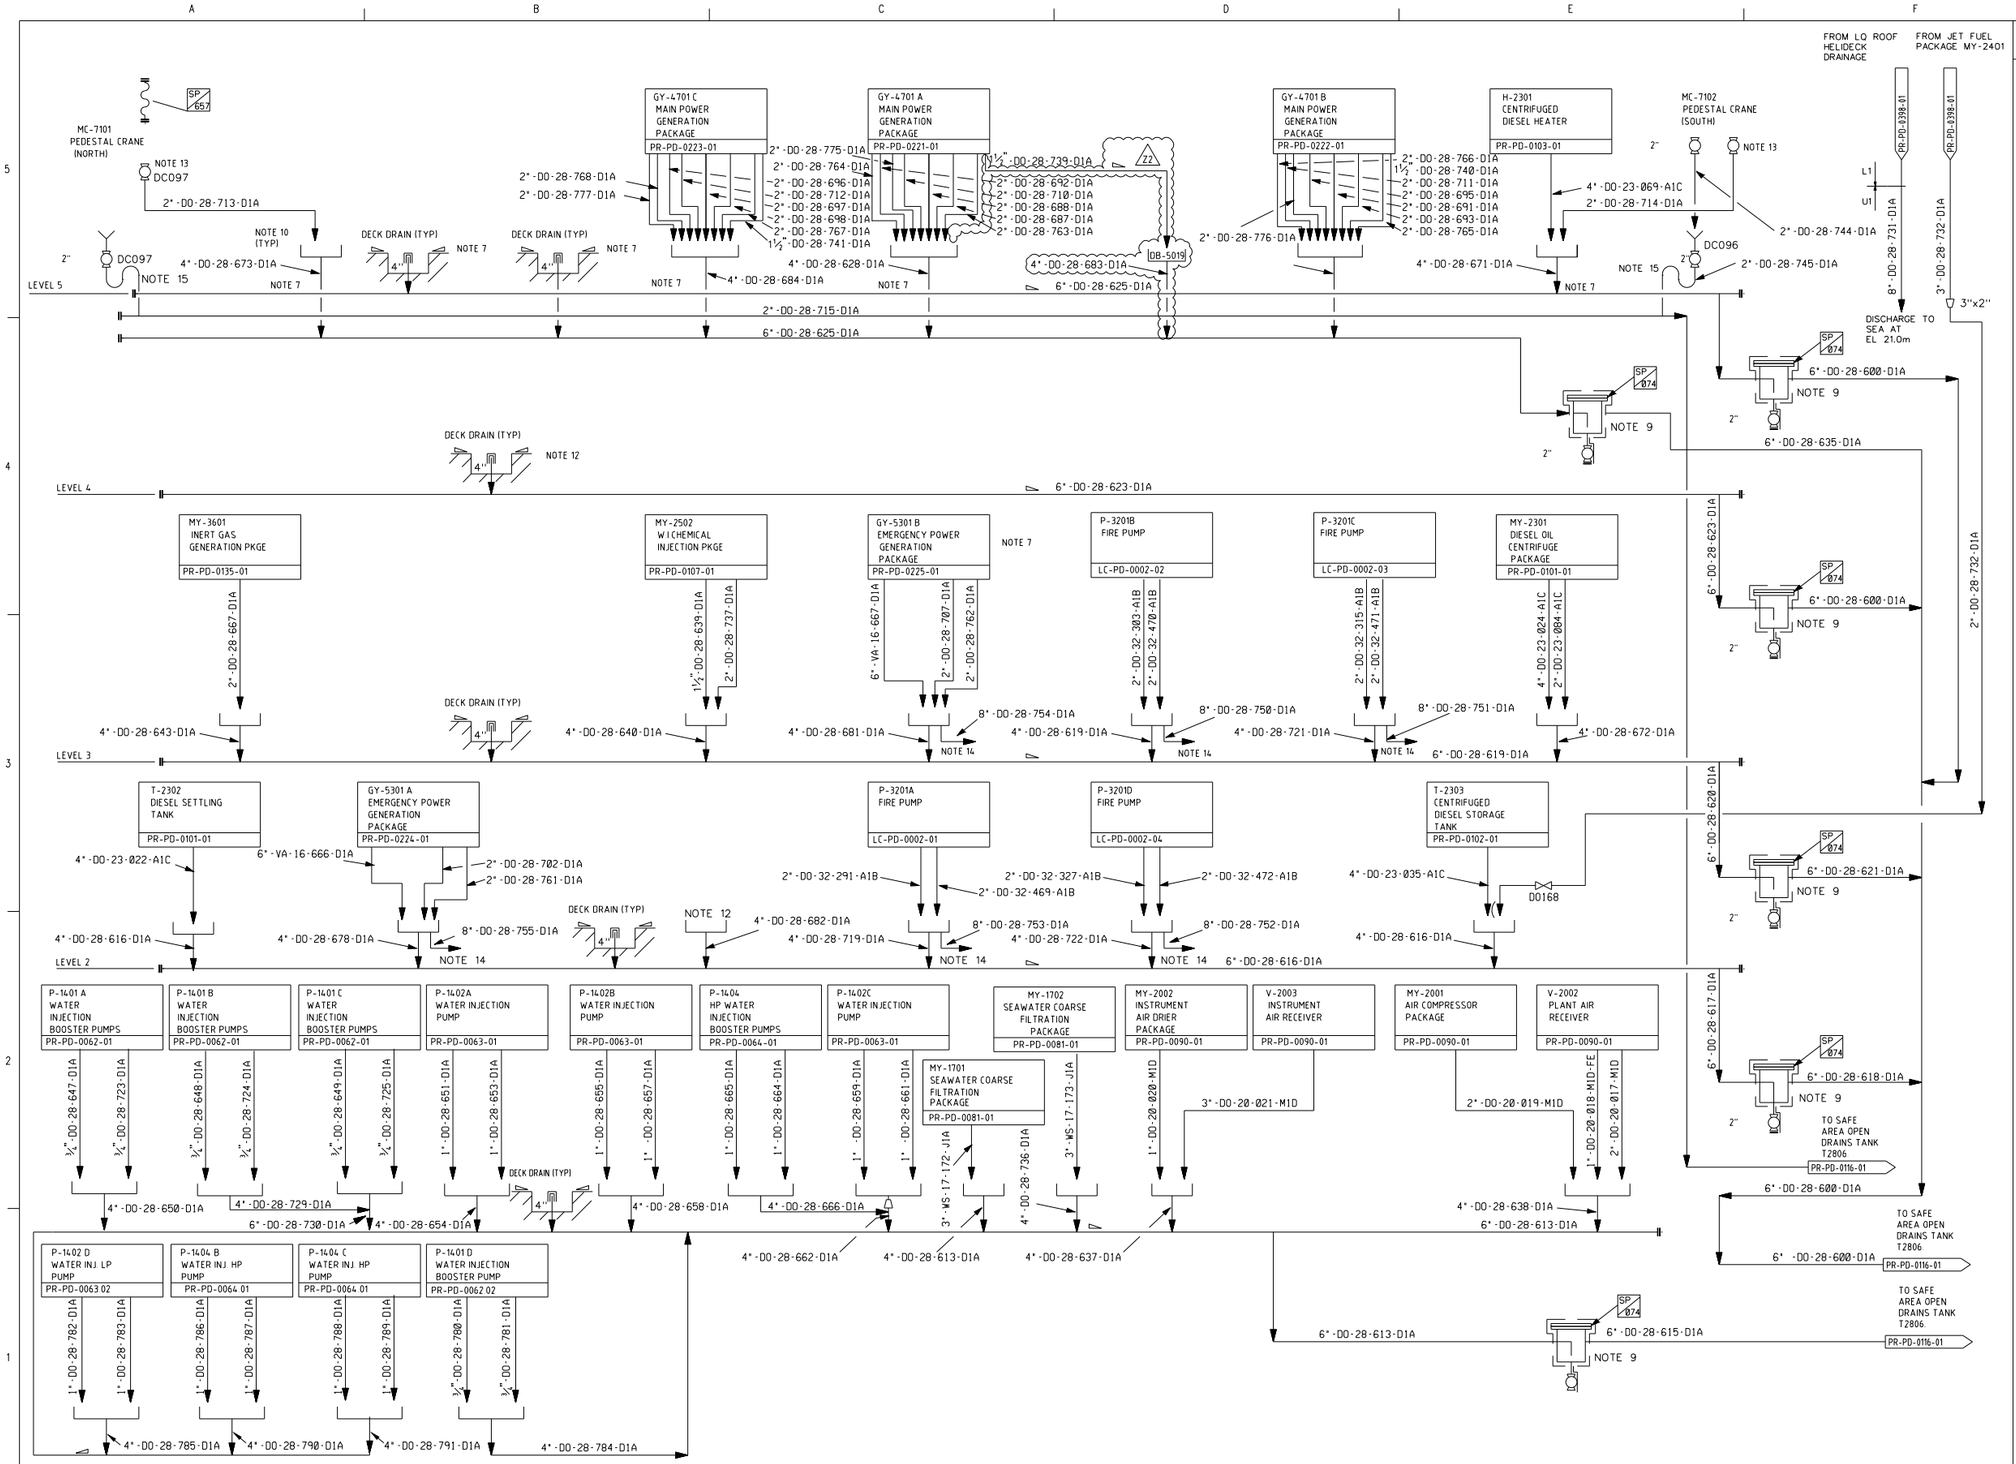


## NOTES

1. RODDING POINTS TO BE PROVIDED AT STRATEGIC POINTS AS REQUIRED BY PIPING LAYOUT.
2. ALL LINES TO GRAVITY DRAIN WITH A MINIMUM SLOPE OF 1 IN 100 AND NO POCKETS.
3. DELETED.
4. DRAIN LINE FROM BOX TO OPEN DRAINS HEADER TO HAVE MESH CAP TO PREVENT INGRESS OF DEBRIS.
5. ALL PACKAGE SKID DRAINS TO BE HARD PIPED TO NEAREST DRAIN BOX.
6. DRAINAGE FROM HELIDECK, WHERE NO OIL IN WATER CONTAMINATION WILL OCCUR, TO BE ROUTED DIRECTLY OVERBOARD.
7. DRAIN BOXES NOT TO BE CONNECTED TO OPEN DRAINS SYSTEM WITHIN HAZARDOUS AREAS.
8. DRAIN LINES TO BE ROUTED TO ADJACENT DECK DRAIN GULLEY WHERE POSSIBLE.
9. LEVEL SEAL POTS TO INCLUDE FACILITY FOR INSTALLATION OF TEMPORARY STRAINERS.
10. TYPICAL DRAINBOX WITH FIREWATER OVERFLOW IS AS BELOW.

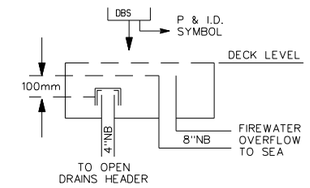


TYPE A DRAINBOX
TYPICAL FOR DECK AREAS
COVERED BY DELUGE SYSTEM
(NOTE4)

11. TYPICAL DRAINBOX WITHOUT FIREWATER OVERFLOW.

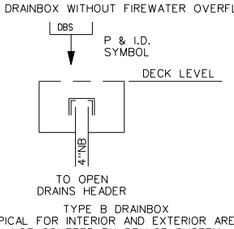


TYPE B DRAINBOX
TYPICAL FOR INTERIOR AND EXTERIOR AREAS
NOT COVERED BY DELUGE SYSTEM
(NOTE4)

12. EACH HVAC PLANT ROOM TO BE PROVIDED WITH A DRAIN BOX.
13. LINES TO TERMINATE AT PEDESTAL CRANE EL. 69000
14. DELUGE LINES TO TERMINATE 2M OFF PLATFORM SIDE ON EACH LEVEL.
15. SEAL LOOP TO BE MINIMUM 2000mm LIQUID HEIGHT

ONLY ACTIVATED TRACE HEATING IS SHOWN ON P & ID, ALL OTHER INSTALLED TRACE HEATING IS NOT ACTIVATED AND NOT SHOWN ON P & ID.

FOR APPROVAL SIGNATURES SEE ARCHIVED DRAWING AT REV 0

REFERENCE DRAWINGS

| DRG.No. | REV | TITLE |
|---|---|---|
| | | DCP 5000 - AH355 ARN 2124 (EP-208) |
| | | DCP 5000 - AH350 ARN 2189 (EP-199) |
| | | DCP 5000 - AH737 ARN 3937 (EP-242) |
| | | DCP 5000 - 770 ARN 6527 (EP-254) |
| | | DCP 5000 - 737 ARN 7483 (EP-242) |
| | | DCP 5000 - AH1054 |

| REV | REASON FOR ISSUE | DATE | DRN | BY ENG | ENG CHECK | L.E. APP'D | CNOOC APP'D |
|---|---|---|---|---|---|---|---|
| Z2 | AS-BUILT FOR SMOC1928 | 23/04/21 | DR | TF | JL | JL | TR |
| Z1 | AS-BUILT FOR SEQ1556 | 07/03/18 | ppLM | LM | LM | JL | TR |
| 14 | AKERKVAERNER AS-BUILT FOR SEQ1147 | 31/01/06 | IAG | PB | NW | NW | SC |

| REV | REASON FOR ISSUE | DATE | DRN | BY ENG | ENG CHECK | L.E. APP'D | CNOOC APP'D |
|---|---|---|---|---|---|---|---|

THIS IS A C.A.D. PRODUCED DRAWING AND SHOULD NOT BE MANUALLY MODIFIED

SCOTT

Worley energy | chemicals | resources

TITLE: PIPING AND INSTRUMENT DIAGRAM OPEN DRAINS COLLECTION HEADERS U.Q.

DRAWING No. SCOTT-FW-0000-PR-PD-0115-01 | Z2 | NONE

| PROJECT | ORIG | AREA/MOD | DISC | TYPE | SEQ. No. | SHT. | REV | SCALE |
|---|---|---|---|---|---|---|---|---|