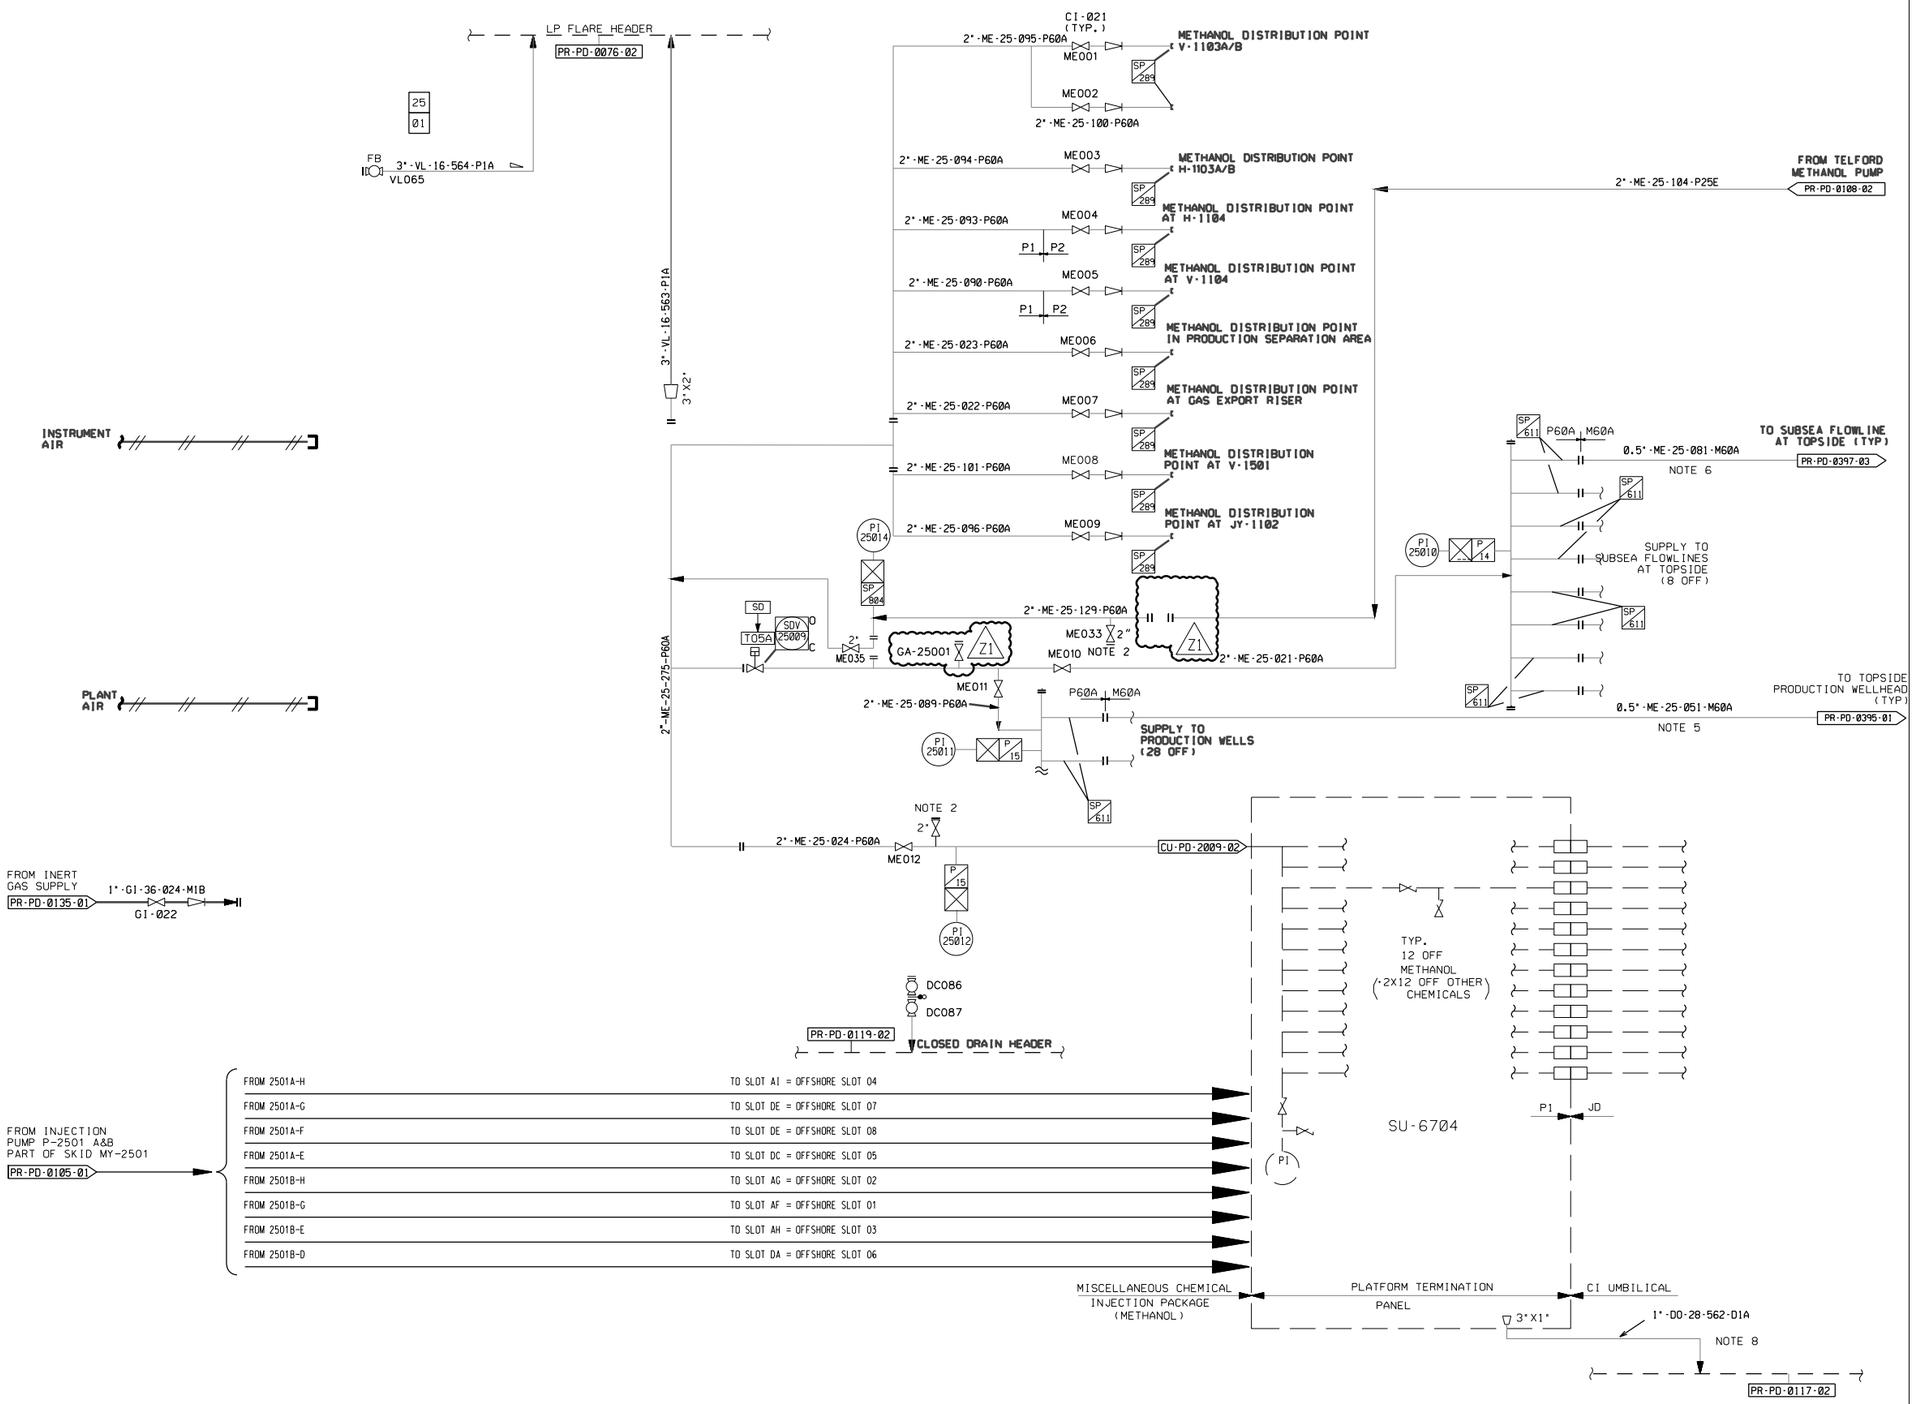

NOTES

1. DELETED
2. SPARE CONNECTION MAY BE USED FOR INJECTION OF OTHER CHEMICALS
3. DELETED
4. DELETED
5. TOPSIDE WELLS LINE NUMBERS 0.5"-ME-25-051-M60A TO 0.5"-ME-25-078-M60A
6. SUBSEA FLOWLINES LINE NUMBERS 0.5"-ME-25-081-M60A TO 0.5"-ME-25-088-M60A (8 OFF)
7. DELETED
8. METHANOL UMBILICAL TO BE DEPRESSURED AFTER USE TO AVOID LEAKAGE INTO MARSHALLING BOX VIA UMBILICAL ANNULUS.
9. DELETED

ONLY ACTIVATED TRACE HEATING IS SHOWN ON P & ID. ALL OTHER INSTALLED TRACE HEATING IS NOT ACTIVATED AND NOT SHOWN ON P & ID.

FOR APPROVAL SIGNATURES SEE ARCHIVED DRAWING AT REV 0

REFERENCE DRAWINGS

DRG.No.	REV	TITLE

REV	REASON FOR ISSUE	DATE	DRN.	CKD.	BY ENG	ENG CKD.	L.E. APP'D	CNOOC APP'D
16	AS BUILT PER SEQ1470	17/10/12	AC	CMA	CMA	NW	NW	TR
15	AS BUILT TO INCLUDE S1088	30/05/05	CAM	TSB	SH	TSB	SC	
14	AS BUILT FOR EIR 0044	28/01/97	DR					
13	AS BUILT FOR TELFORD	28/01/97	DH	GWM				
12	AS BUILT TO INCLUDE DO-254	22/06/95	WN	GWM	KJH			
11	AS COMMISSIONED	12/05/94	RTS	RM	KJH			

REV	REASON FOR ISSUE	DATE	DRN.	CKD.	BY ENG	ENG CKD.	L.E. APP'D	CNOOC APP'D
17	AD HOC AS BUILT	26/11/14	LB	TT	TT	AH	AH	TR

cnooc

THIS IS A C.A.D. PRODUCED DRAWING AND SHOULD NOT BE MANUALLY MODIFIED

SCOTT

Worley

TITLE

PIPING & INSTRUMENT DIAGRAM
MISCELLANEOUS CHEMICAL INJECTION PACKAGE

DRAWING No.

SCOTT-FW-0000-PR-PD-0106-01

Z1 | NONE

PROJECT	ORIG	AREA/MOD	DISC	TYPE	SEQ. No.	SHT.	REV	SCALE