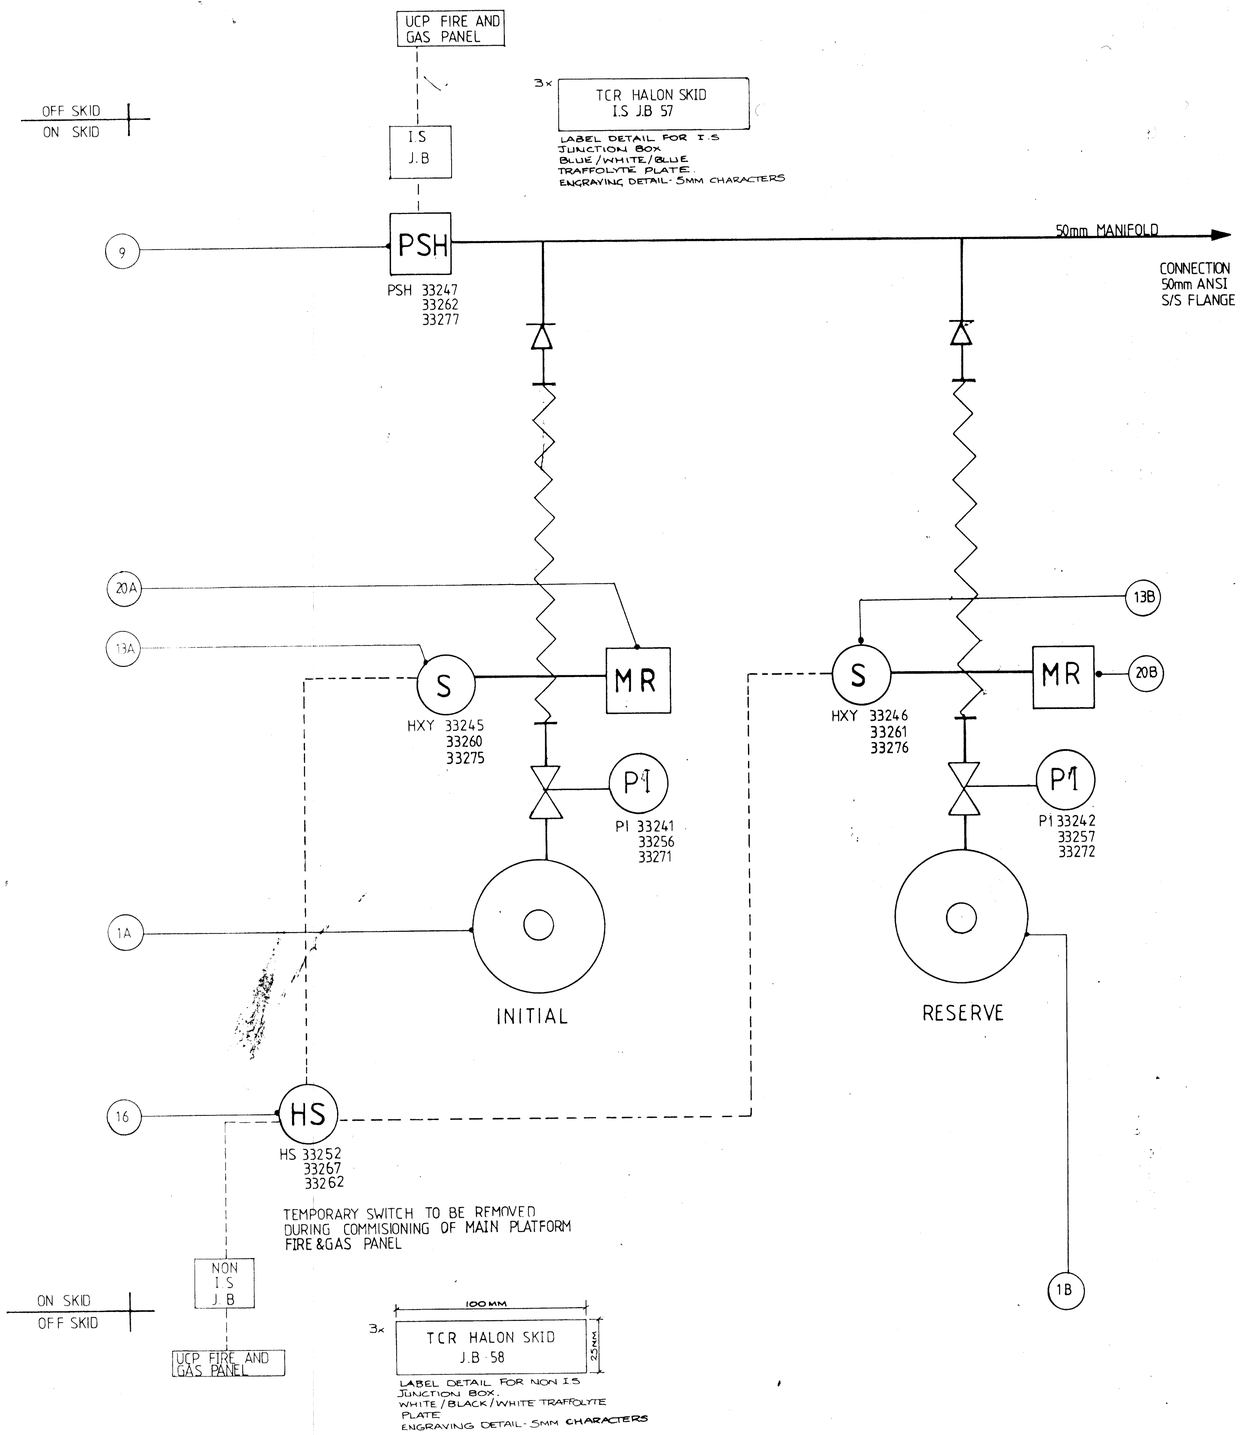

REF	QTY	DESCRIPTION	MFR.	PART No.
1A	1	INITIAL DISCHARGE CYLINDER FILLED 35KG HALON 1301	FFE	PSY23009-1
1B	1	RESERVE DISCHARGE CYLINDER FILLED 35KG HALON 1301	FFE	PSY23009-1
9	1	GAS DISCHARGED PRESSURE SWITCH (SETTING - 10 BAR RISING)	DELTA	A20102Q284
13A	1	INITIAL DISCHARGE SOLENOID	FFE	PAE 22996-1
13B	1	RESERVE DISCHARGE SOLENOID	FFE	PAE 22996-1
14				
15				
16	1	INITIAL/RESERVE SELECTOR SWITCH	WALSALL	GVU/RA
20A	1	INITIAL CYLINDER MANUAL ACTUATOR	FFE	3AE 21382
20B	1	RESERVE CYLINDER MANUAL ACTUATOR	FFE	3AE 21382

REF	TAG NUMBERS SKID A	SKID B	SKID C
HALON SKID	LH 3308 A	LH 3308B	LH 3308 C
PI	PI 33241 33242	PI 33256 33257	PI 33271 33272
S	HXY 33245 33246	HXY 33260 33261	HXY 33275 33276
PSH	PSH 33247	PSH 33262	PSH 33277
HS	HS 33252	HS 33267	HS 33262
I.S J.B	I.S JB 57	I.S J.B 57	I.S J.B 57
NON I.S J.B	J.B 58	J.B 58	J.B 58

AMERADA HESS LIMITED
Scott Field Development

RETURN CODE 8

THIS DOCUMENT HAS BEEN ACCEPTED BY COMPANY AS "AS SUPPLIED" WITHOUT ENGINEERING REVIEW

AS SUPPLIED

Seller shall complete both Sections A & B, sign & date

A All Company comments on previous submission have been fully incorporated
☐ Yes ☐ No ☑ Not Applicable

B There are no design changes, other than incorporation of Company comments, from previous submission
☑ Yes ☐ No

Seller's Verifying Statement:
This document accurately represents the "As Supplied" condition of the Work

Sellers Authorised Signature: JCW Date: 26/6/92

COMPANY RETURN CODES

- ☐ 1. Accepted "As Supplied"
- ☐ 2. Accepted - No Comments
- ☐ 3. Qualified Acceptance - Minor Comments. Revise & Resubmit as "As Supplied" Work May Proceed
- ☐ 4. Qualified Acceptance - Minor Comments. Revise & Resubmit To Obtain Code 2 Work May Proceed
- ☐ 5. Qualified Acceptance - Major Comments. Revise & Resubmit To Obtain Code 2 Work May Proceed
- ☐ 6. Rejected - Revise & Resubmit Immediately Work May Not Proceed In The Affected Areas
- ☐ 7. Review Not Required

Company's Signature Date

AMERADA HESS LIMITED
SCOTT FIELD DEVELOPMENT

Package Desc	MAIN POWER GENERATION PACKAGE
Equip Nos	5Y4701 A/B/C
SDRS Codes	D01
Module	W1 Sheet 1 of 1
Purchase Order No	P0001
Document No	D 0005
Rev	06

HOW REF. DRG. 22886-7
R.G.T REF. No. C/0032

R.G.T. ORDER No. B04146
R.G.T. SPEC. No. 64/91002221 & 64/91002222

A	REDRAWN PJ 3.10.90		
B	REDRAWN PJ 29.10.90		
C	LOW PRESSURE SWITCHES CHANGED TO HIGHER CLIENTS COMMENTS 5.1.91		
D	REVISED AS PER RGT COMMENTS DATED 18/12/90 IG 30/1/91		
E	REVISED AS PER CLIENTS COMMENTS 1.3.91	15.4.91	
F	REVISED AS PER RGT COMMENTS 3.6.91 AS BUILT PJ 26.6.91		

DRG. REF.	REV.	DATE
CONTROL ROOM LAYOUT	B	2.11.90
[illegible]	E	15.4.91
[illegible]	F	3.6.91

LEGEND

PS	GAS CONE PRESSURE SWITCH	HS	INITIAL/RESERVE SELECTOR SWITCH
	CHECK VALVE	----	INSTR. ELEC. SIGNAL
PI	PRESSURE INDICATOR		FLEXIBLE HOSE
O	HALON CYLINDER		
MR	MECHANICAL MANUAL RELEASE		
S	SOLENOID ACTUATOR		

NOTES FOR HOW ENGINEER

NOTES FOR ELECTRICAL CONTRACTOR

CONTROL ROOM HALON SKID JUNCTION BOX LABELS 57 & 58 WILL BE MOUNTED ADJACENT TO THE RESPECTIVE JUNCTION BOXES

BUILDERS WORK CLIENTS TO ARRANGE FOR SPECIALIST TRADES FOR WORK SUCH AS CUTTING AWAY EXCAVATING AND MAKING GOOD WHERE REQUIRED CLIENTS TO ARRANGE DRILLING SPECIAL HOLES IN DUCTING TILES MARBLE WALLS ETC.

CONTRACT No: 22886
PROJECT: AMERADA HESS
CLIENT: R.G.T.
DATE: 29.10.90
SCALE: N.T.S
DRAWN BY: P.J
ENGINEER: H.H
CHECKED BY:
TRACED BY:
APPROVED BY:

How Fire Limited
Coneygre Road, Tipton, West Midlands DY4 8XL

OFFICE OF ISSUE: TIPTON

TITLE: P & ID HALON EQUIPMENT LAYOUT - CONTROL ROOM

DRAWING No. 22886-10 /A1

REV ØAØBØCØEØF

G&M PUNN 04033