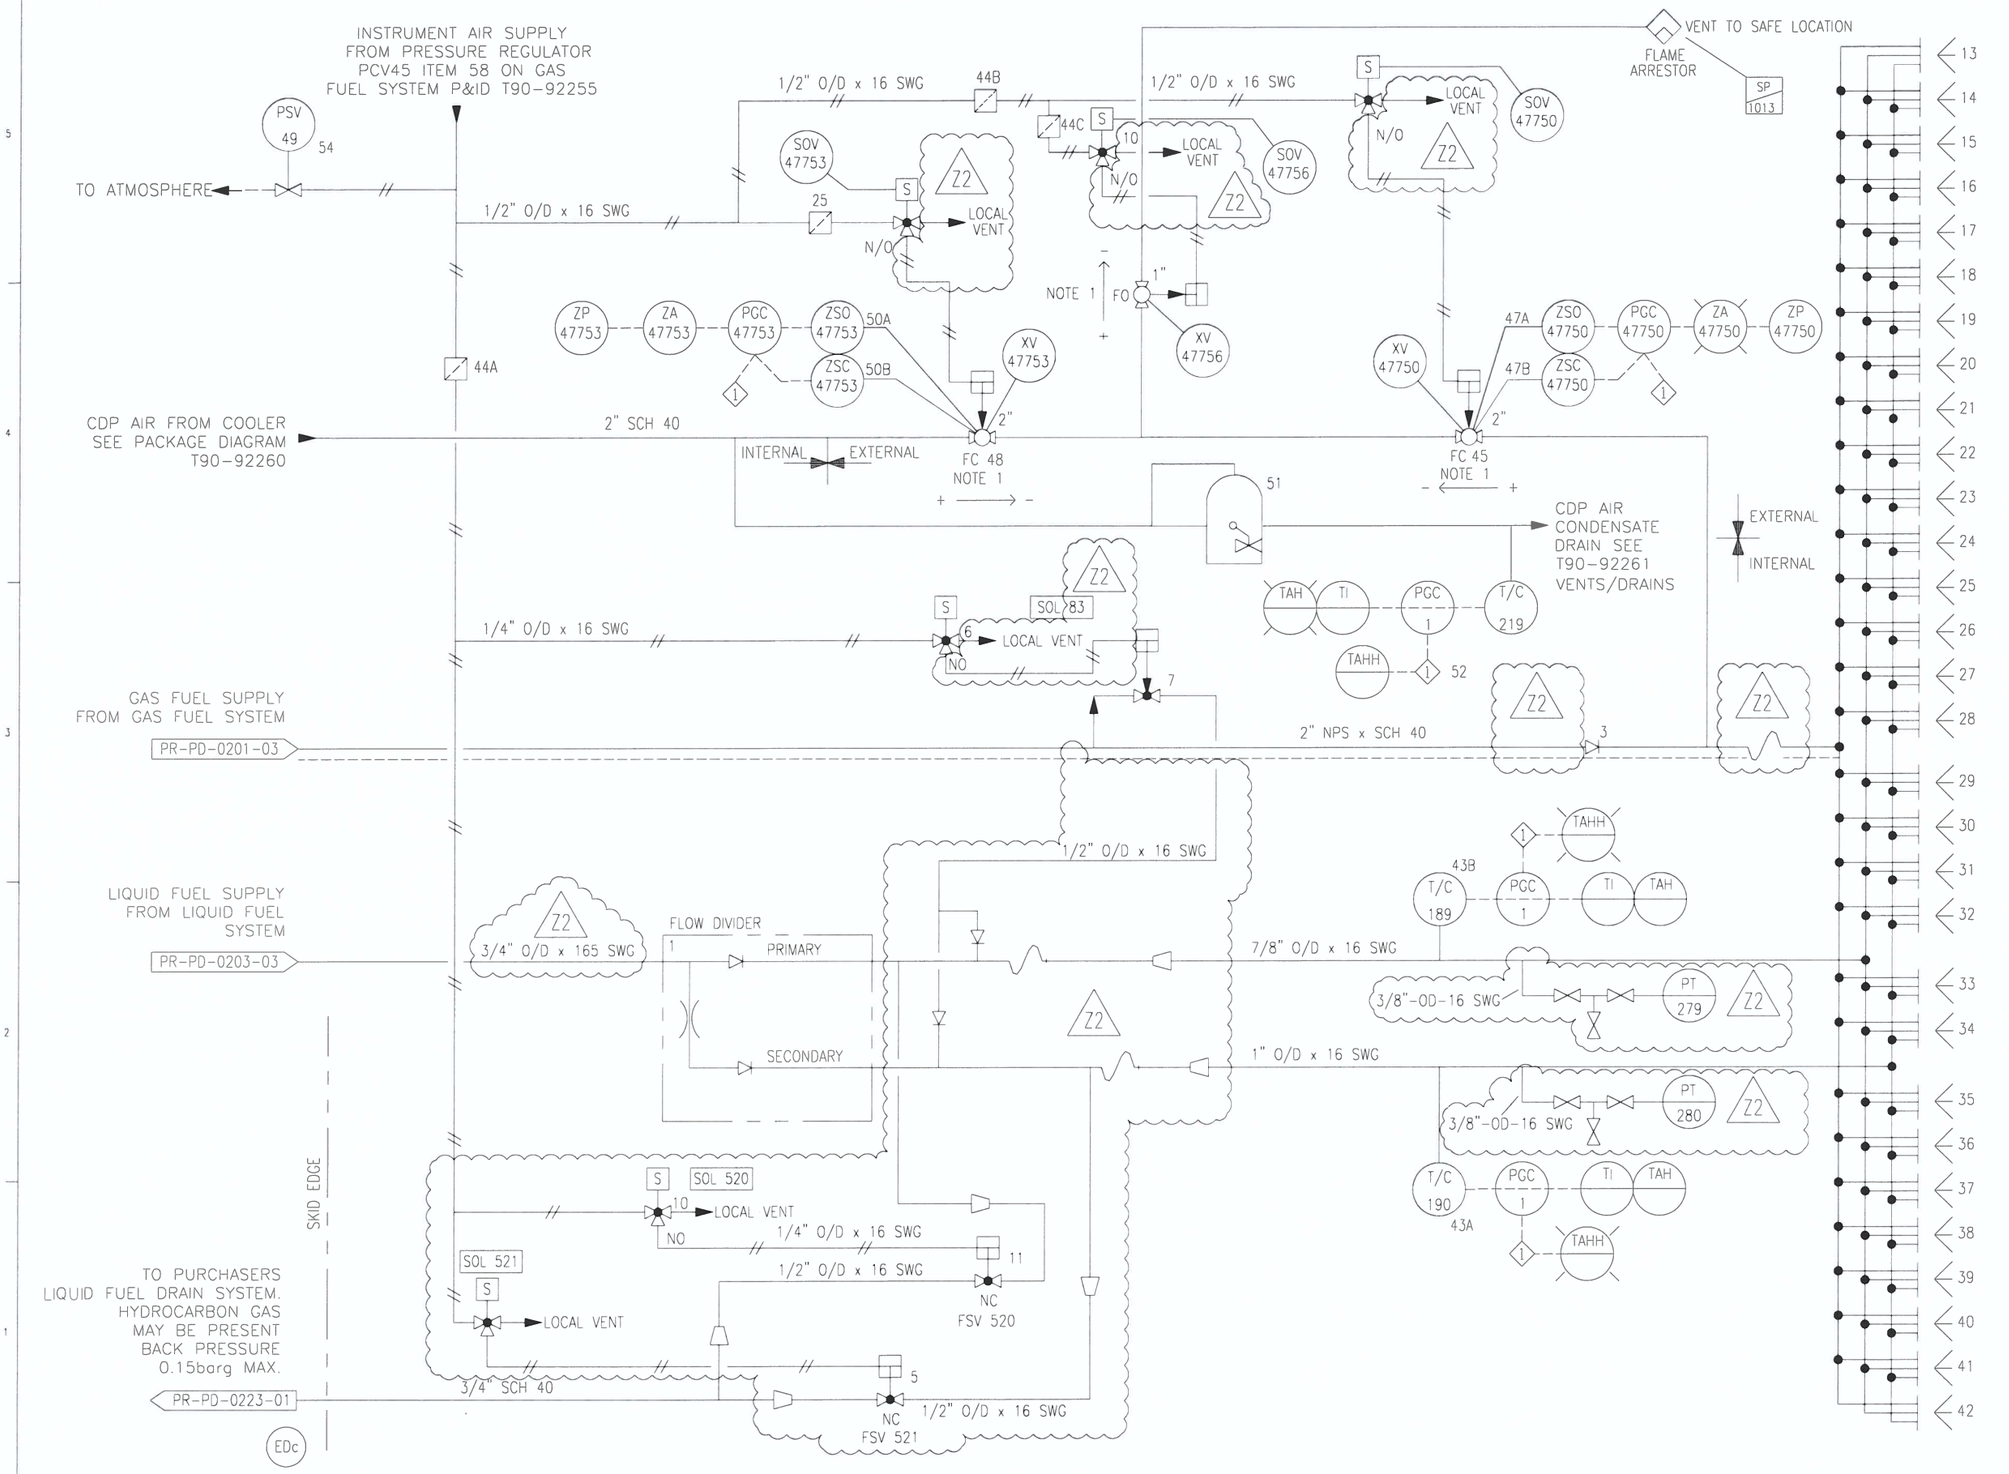

NOTES

1. PREFERENTIAL DIRECTION SEALED VALVE. ARROW INDICATES PRESSSURE DIFFERENTIAL FROM HIGH (+) TO LOW (−) IN CLOSED POSITION.

REFERENCE DRAWINGS

DRG.No.	REV	TITLE

REV	REASON FOR ISSUE	DATE	DRN.	CKD.	BY ENG	ENG CKD.	L.E. APP'D	NEXEN APP'D
Z2	AS-BUILT FOR SIC0076	10/01/20	NE	NE	NE	TP	L	M
Z1	AS-BUILT AS PER SEQ1248	07.12.16	LM	LM	LM	AH	AH	TR

REV	REASON FOR ISSUE	DATE	DRN.	CKD.	BY ENG	ENG CKD.	L.E. APP'D	NEXEN APP'D

cnooc

THIS IS A C.A.D. PRODUCED DRAWING AND SHOULD NOT BE MANUALLY MODIFIED

SCOTT

Worley
energy | chemicals | resources

TITLE
PIPING & INSTRUMENTATION DIAGRAM
DUAL FUEL COMPONENT
(PACKAGE C)

DRAWING No.
SCOTT-AK-0000-PR-PD-0202-03

Z2 | NTS

PROJECT	ORIG	AREA/MOD	DISC	TYPE	SEQ. No	SHT.	REV	SCALE