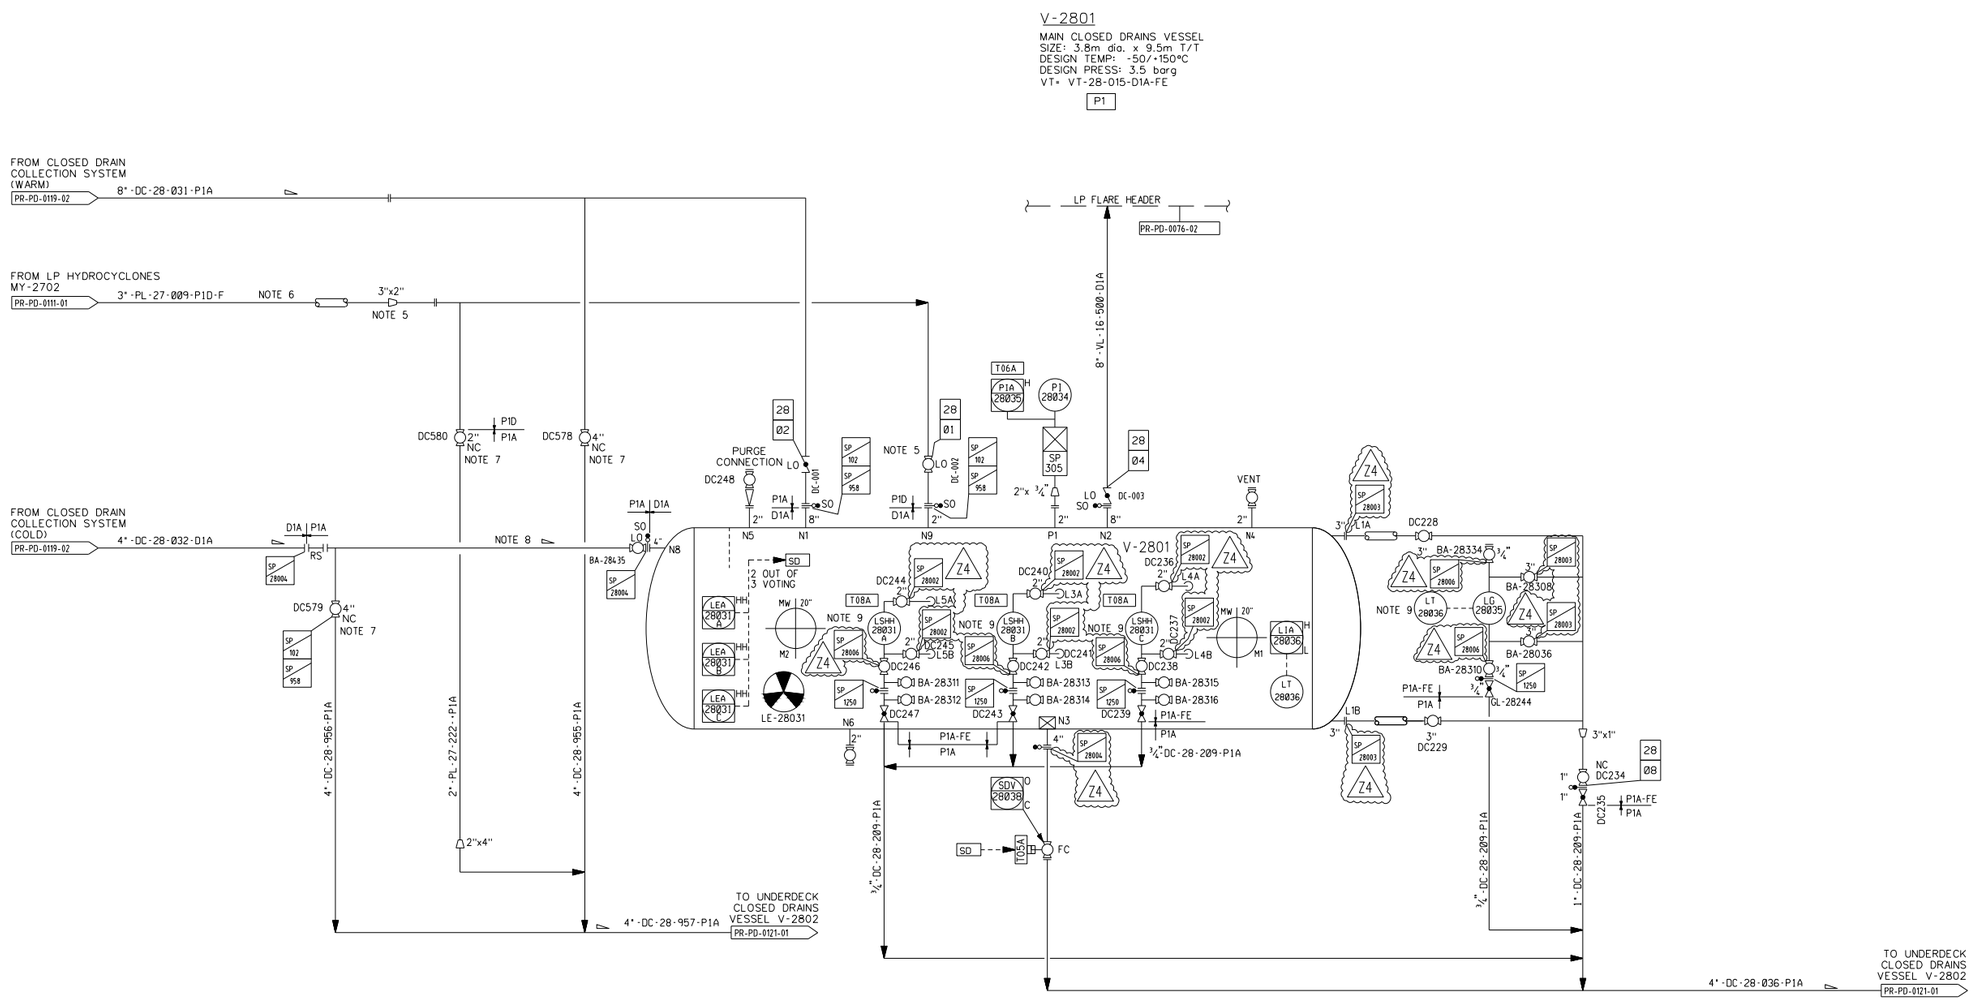

NOTES

1. DELETED.
2. DELETED.
3. DELETED.
4. DELETED.
5. MINIMUM DISTANCE FROM VESSEL.
6. DELETED.
7. V-2801 BYPASS VALVES WILL BE LOCKED OPEN FOR DURATION OF BYPASS OPERATION. THIS WILL BE CONTROLLED UNDER NOPRAS.
8. LINE IS FREE DRAINING WITH NO POCKETS AND HAS A MINIMUM SLOPE OF 1:100.
9. REDUNDANT LSHH-28031A/B/C AND LT-28036.

ONLY ACTIVATED TRACE HEATING IS SHOWN ON P & ID, ALL OTHER INSTALLED TRACE HEATING IS NOT ACTIVATED AND NOT SHOWN ON P & ID.

FOR APPROVAL SIGNATURES SEE ARCHIVED DRAWING AT REV 0

REFERENCE DRAWINGS

DRG.No.	REV	TITLE
		DCP 5000-AH 1054
		DCP-5000-729 ARN 6407 (EPJ-0140)
		DCP 5000 ARN 1986 (EP-206)

REV	REASON FOR ISSUE	DATE	DRN.	CKD.	BY ENG	ENG CKD.	L.E. APP'D	CNOOC APP'D
Z1	AS-BUILT FOR SEQ1669	01.05.15	GP	PG	PG	CE	AH	TR
15	AS BUILT TO INCLUDE S1088	30.05.05	CAM	TSB		SH	TSB	SC
14	AS BUILT TO REFLECT SEQ-1080	12.12.03	GPG			BH	BH	MS
13	AS BUILT TO INCLUDE SEQ 808	10.10.02	TM	BH		SAS		
12	AS BUILT TO INCLUDE DO-254	22.06.95	WN	GWM				
11	AS COMMISSIONED	29.04.94	RTS	RM		KJH		

REV	REASON FOR ISSUE	DATE	DRN.	CKD.	BY ENG	ENG CKD.	L.E. APP'D	CNOOC APP'D
Z4	AS-BUILT FOR SEQ1669	13.04.21	DR	SM	SM	TF	JL	TR
Z3	AS-BUILT FOR SMOC1860	21.12.17	DD	LM	LM	JL	JL	TR
Z2	AS-BUILT FOR SMOC1860	03.11.17	DD	LM	LM	SB	SB	TR

THIS IS A C.A.D. PRODUCED DRAWING AND SHOULD NOT BE MANUALLY MODIFIED

SCOTT

Worley energy | chemicals | resources

TITLE
PIPING & INSTRUMENT DIAGRAM
MAIN CLOSED DRAINS VESSEEL

DRAWING No.
SCOTT-FW-0000-PR-PD-0120-01

Z4 | NONE

PROJECT	ORIG	AREA/MOD	DISC	TYPE	SEQ. No.	SHT.	REV	SCALE