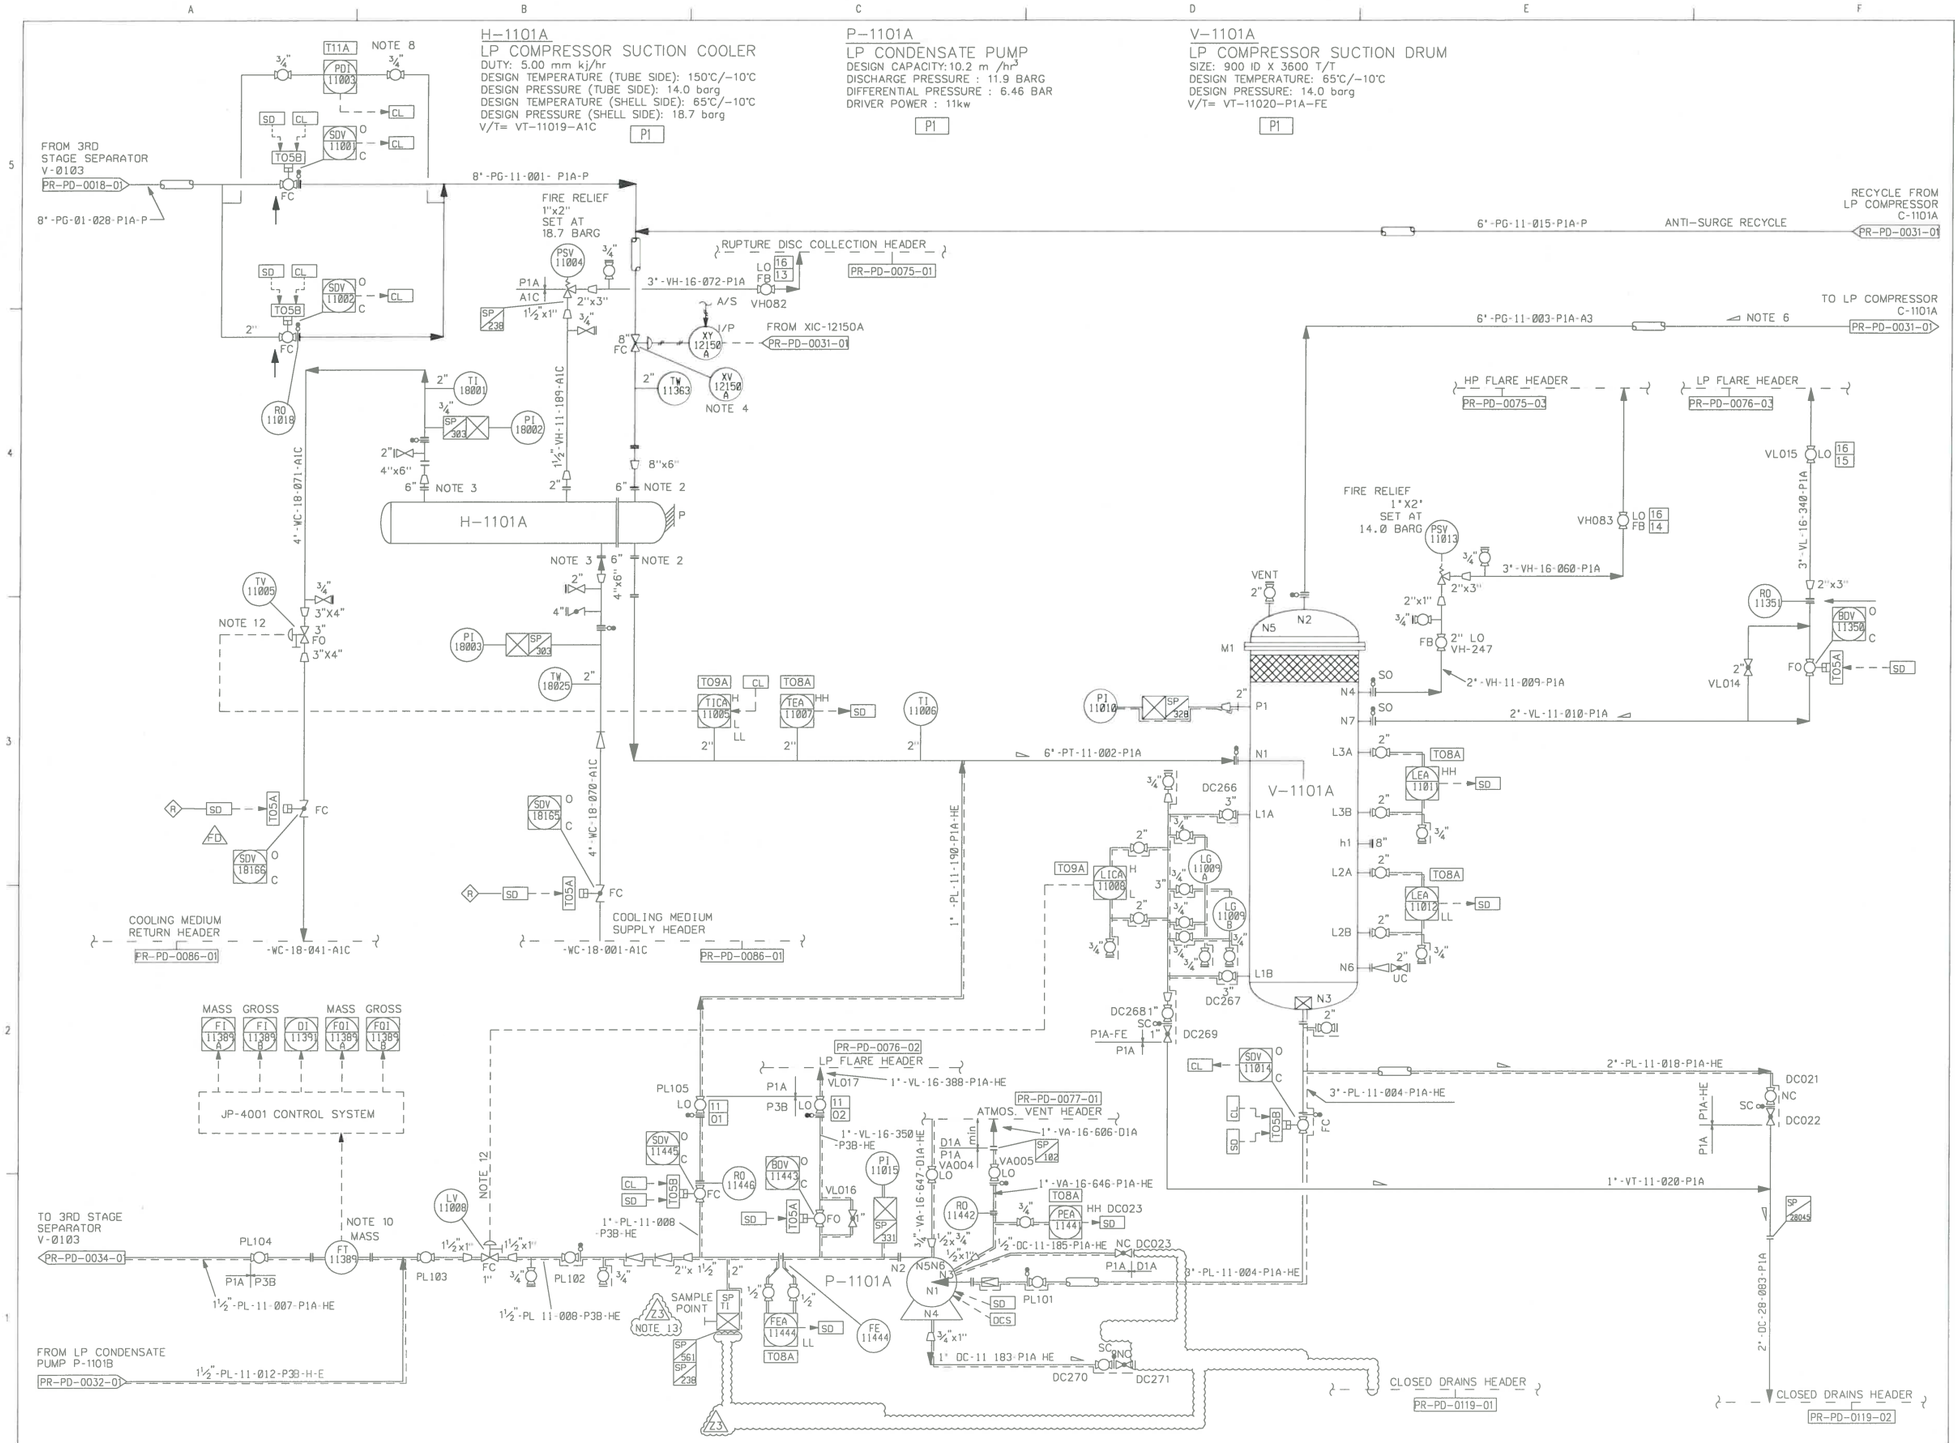

NOTES

1. DELETED
2. SPOOL PIECES ARE REQUIRED FOR EXCHANGER BUNDLE REMOVAL.
3. SPOOL PIECES REQUIRED FOR EXCHANGER MAINTENANCE.
4. VALVE HAS MINIMUM STOP.REDUCED TRIM TO BE REPLACED WITH FULL SIZE TRIM IN YEAR II.
5. PSV AND VENT INLET AND DISCHARGE PIPING ARE NOT TO BE POCKETTED. DISCHARGE PIPING IS TO SLOPE TO FLARE HEADER. MINIMUM SLOPE 50:1.
6. DELETED.
7. ALL DRAIN LINES TO SLOPE TO DRAIN HEADER.
8. PDI TO MONITOR DIFFERENTIAL IN EITHER DIRECTION.
9. DELETED
10. FT-11389 IS SUPPLIED BY SELLER OF JP-4001.
11. DELETED.
12. MILLI-AMPERE INDICATOR INSTALLED ADJACENT TO VALVE.
13. DOWNSTREAM GLOBE VALVE REMOVED FROM SAMPLE TAKE-OFF.

ONLY ACTIVATED TRACE HEATING IS SHOWN ON P & ID, ALL OTHER INSTALLED TRACE HEATING IS NOT ACTIVATED AND NOT SHOWN ON P & ID.

FOR APPROVAL SIGNATURES SEE ARCHIVED DRAWING AT REV 0

REFERENCE DRAWINGS

DRG.No.	REV	TITLE
		DCP-5000-744 ARN 3916 (EP 239)
		DCP-5000-286 ARN 2041 (EP 193)
		DCP-5000-729 ARN 3847 (EPJ 128)
		DCP-5000-755 ARN 6328 (EP 238)
		DCP-5000-AH1054

REV	REASON FOR ISSUE	DATE	DRN.	CKD.	BY ENG	ENG CKD.	L.E. APP'D	NEXEN APP'D
11	AS COMMISSIONED	10.5.94	RTS	RM			KJH	
4	REVISED TO LATEST INFORMATION	14.06.93	KM					
3	AS BUILT							
2	REVISED FOR CONSTRUCTION	03.02.92						
1	REVISED FOR CONSTRUCTION	15.10.91	SMS	GC				
0	APPROVED FOR CONSTRUCTION	07.6.91	RB	GC	RT	JS	BAR	KTL

REV	REASON FOR ISSUE	DATE	DRN.	CKD.	BY ENG	ENG CKD.	L.E. APP'D	NEXEN APP'D
Z3	AS-BUILT FOR SMOC1860	19/07/17	UM	km	km	dl	HL	AL
Z2	AS-BUILT FOR SMOC1860	14.03.17	DD	LM	LM	JL	JL	TR
Z1	AS-BUILT FOR SIC0018	18.08.16	DD	LM	LM	SC	AH	TR
14	UPDATED TO REFLECT SEQ-1080	12.12.03	GPG	SH	DB		MS	19.12.03
13	AS-BUILT TO INCLUDE S970	31.1.03	DT	BH	SSS			
12	AS-BUILT TO INCLUDE DO-254	19.6.95	WN	GWM				

nexen A CNOOC LIMITED COMPANY

THIS IS A C.A.D. PRODUCED DRAWING AND SHOULD NOT BE MANUALLY MODIFIED

SCOTT amec foster wheeler

TITLE
PIPING AND INSTRUMENT DIAGRAM
LP COMPRESSOR SUCTION
COOLER AND DRUM - TRAIN A

DRAWING No.
SCOTT-FW-0000-PR-PD-0030-01 Z3 NONE

PROJECT | ORIG | AREA/MOD | DISC | TYPE | SEQ. No. | SHT. | REV | SCALE